

18285 7050

MYERS SURVEYING CO.

2740 East Main Street, Columbus 9 (Bexley), Ohio

k-24

k-32

Being a 1.220 acre tract shown of record in D.B. 3153, Page 129, and a part of Half Section 29, Township 5, Range 22, Refugee Lands, Columbus, Ohio

for

BALL, GRAVES, HARRIGAN, & BALL


D.B. 3153 Page 129

Scale 1" = 60'

Franklin Co. Rec. Office

September 1, 1971

Rev. Sept. 8, 1971

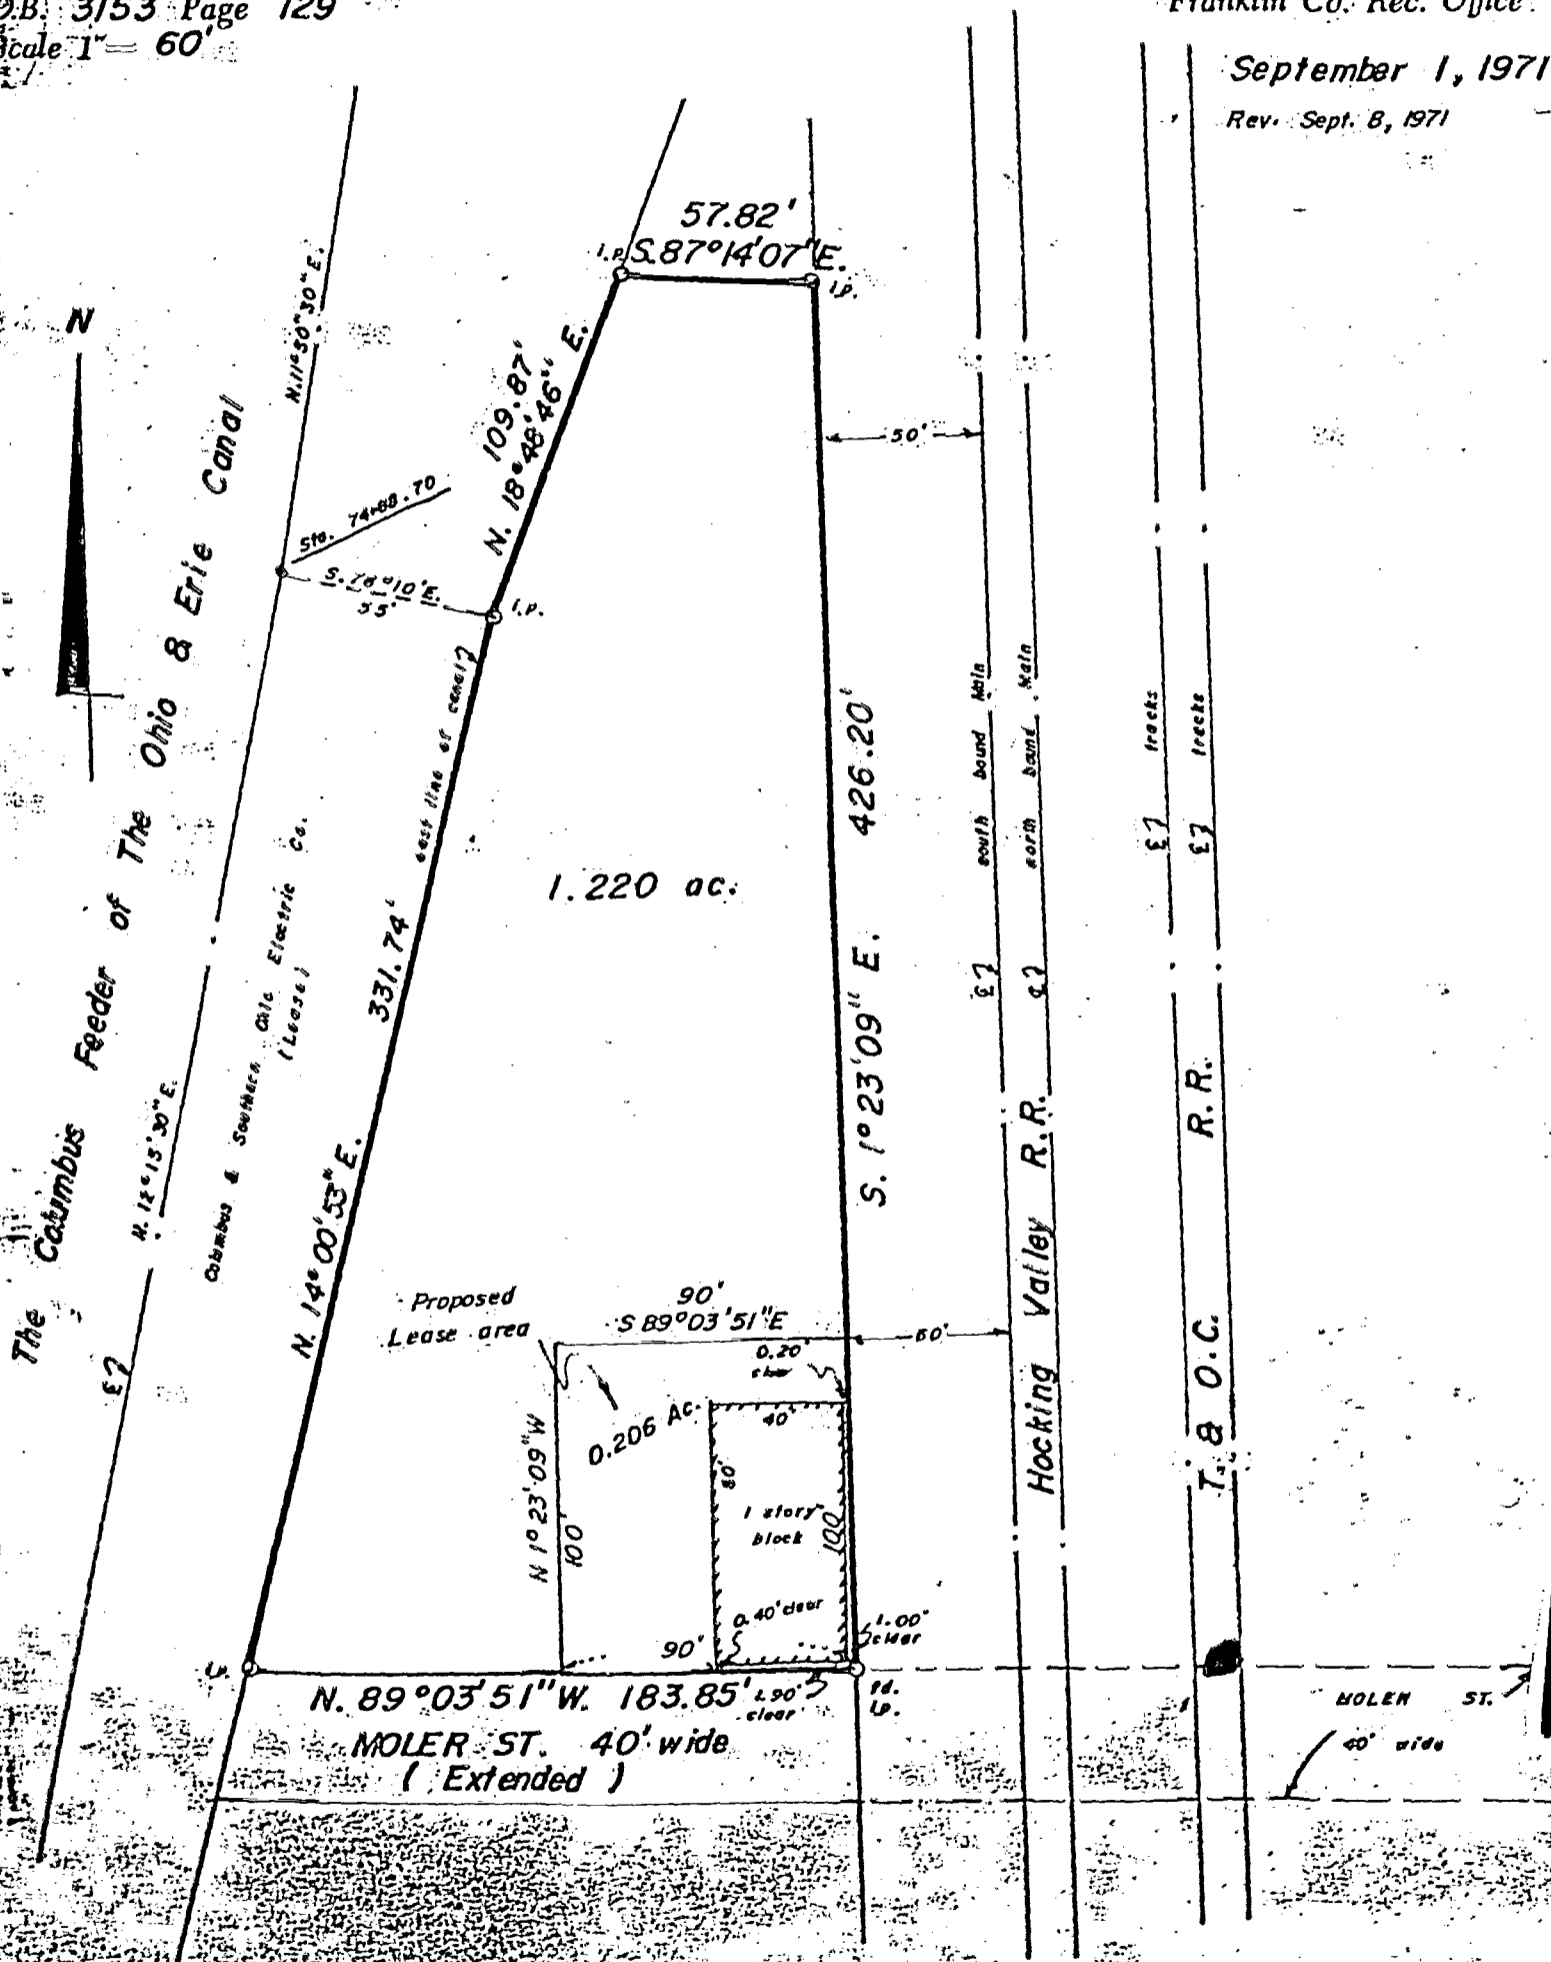

We hereby certify that the foregoing plat was prepared from an actual survey of the premises. No side-line of principal building is less than dimension shown. Iron pins not set unless indicated thus 0.

MYERS SURVEYING CO.

BY *Allan H. Anderson*
Registered Surveyor