

Myers Surveying Company, Inc.

2740 East Main Street, Columbus 43209 (Bexley), Ohio
 614-235-8677 FAX: 614-235-4559



82857050

A Boundary Survey prepared for and certified to:
David Haskell and/or H.A.I. Development

Legal Description: Situated in Ohio, County of Franklin, City of Columbus, Being Part of Lot 2 Deshler, Thurman & Bennett's Subdivision, Plat book 3, Page 158

Applicant: Posted Address: rear of 72 Thurman Ave., Columbus, Ohio

REDBUD ALLEY 17.8'

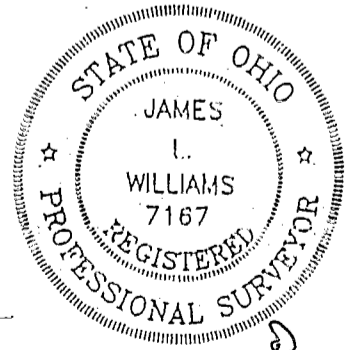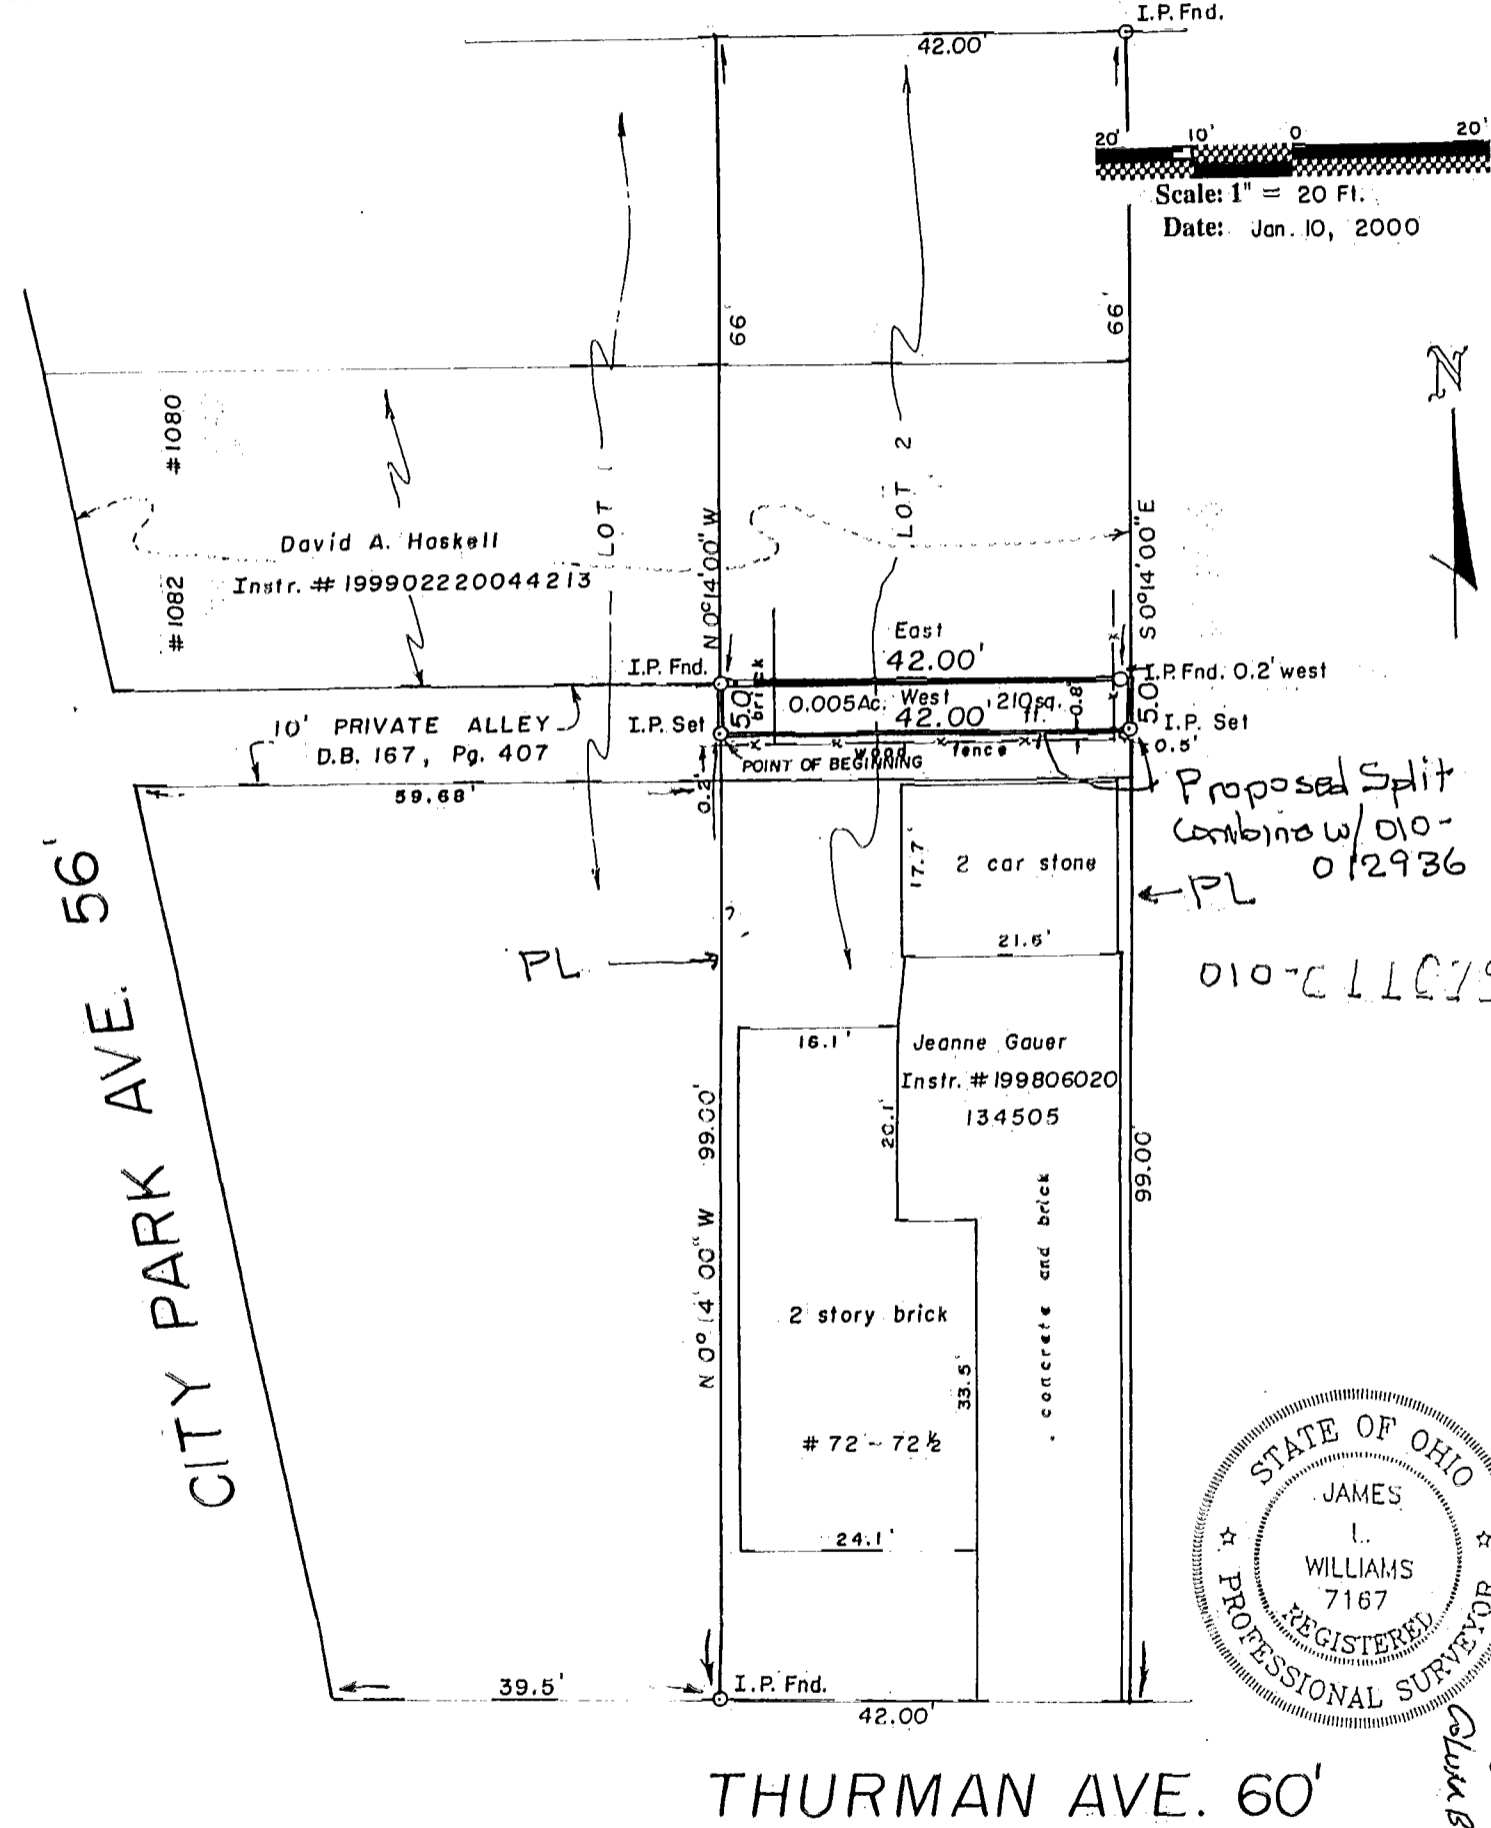

Columbus J-49

We hereby certify that the foregoing Boundary Survey was prepared from actual field measurements in accordance with Chapter 4733-37 Ohio Administrative Code. Iron pins set are 30"x1" O.D. with an orange plastic plug inscribed "P.S. 6579", unless otherwise noted. Basis of bearing is Thurman Avenue held as East-West.

Myers Surveying Co., Inc.

By *James L. Williams*
 Professional Surveyor