


M-206 D  
181606950

SURVEYED PLAT

—○— Denotes Iron Pins  
Scale 1" = 50'

Total Acreage 1.000 Ac.

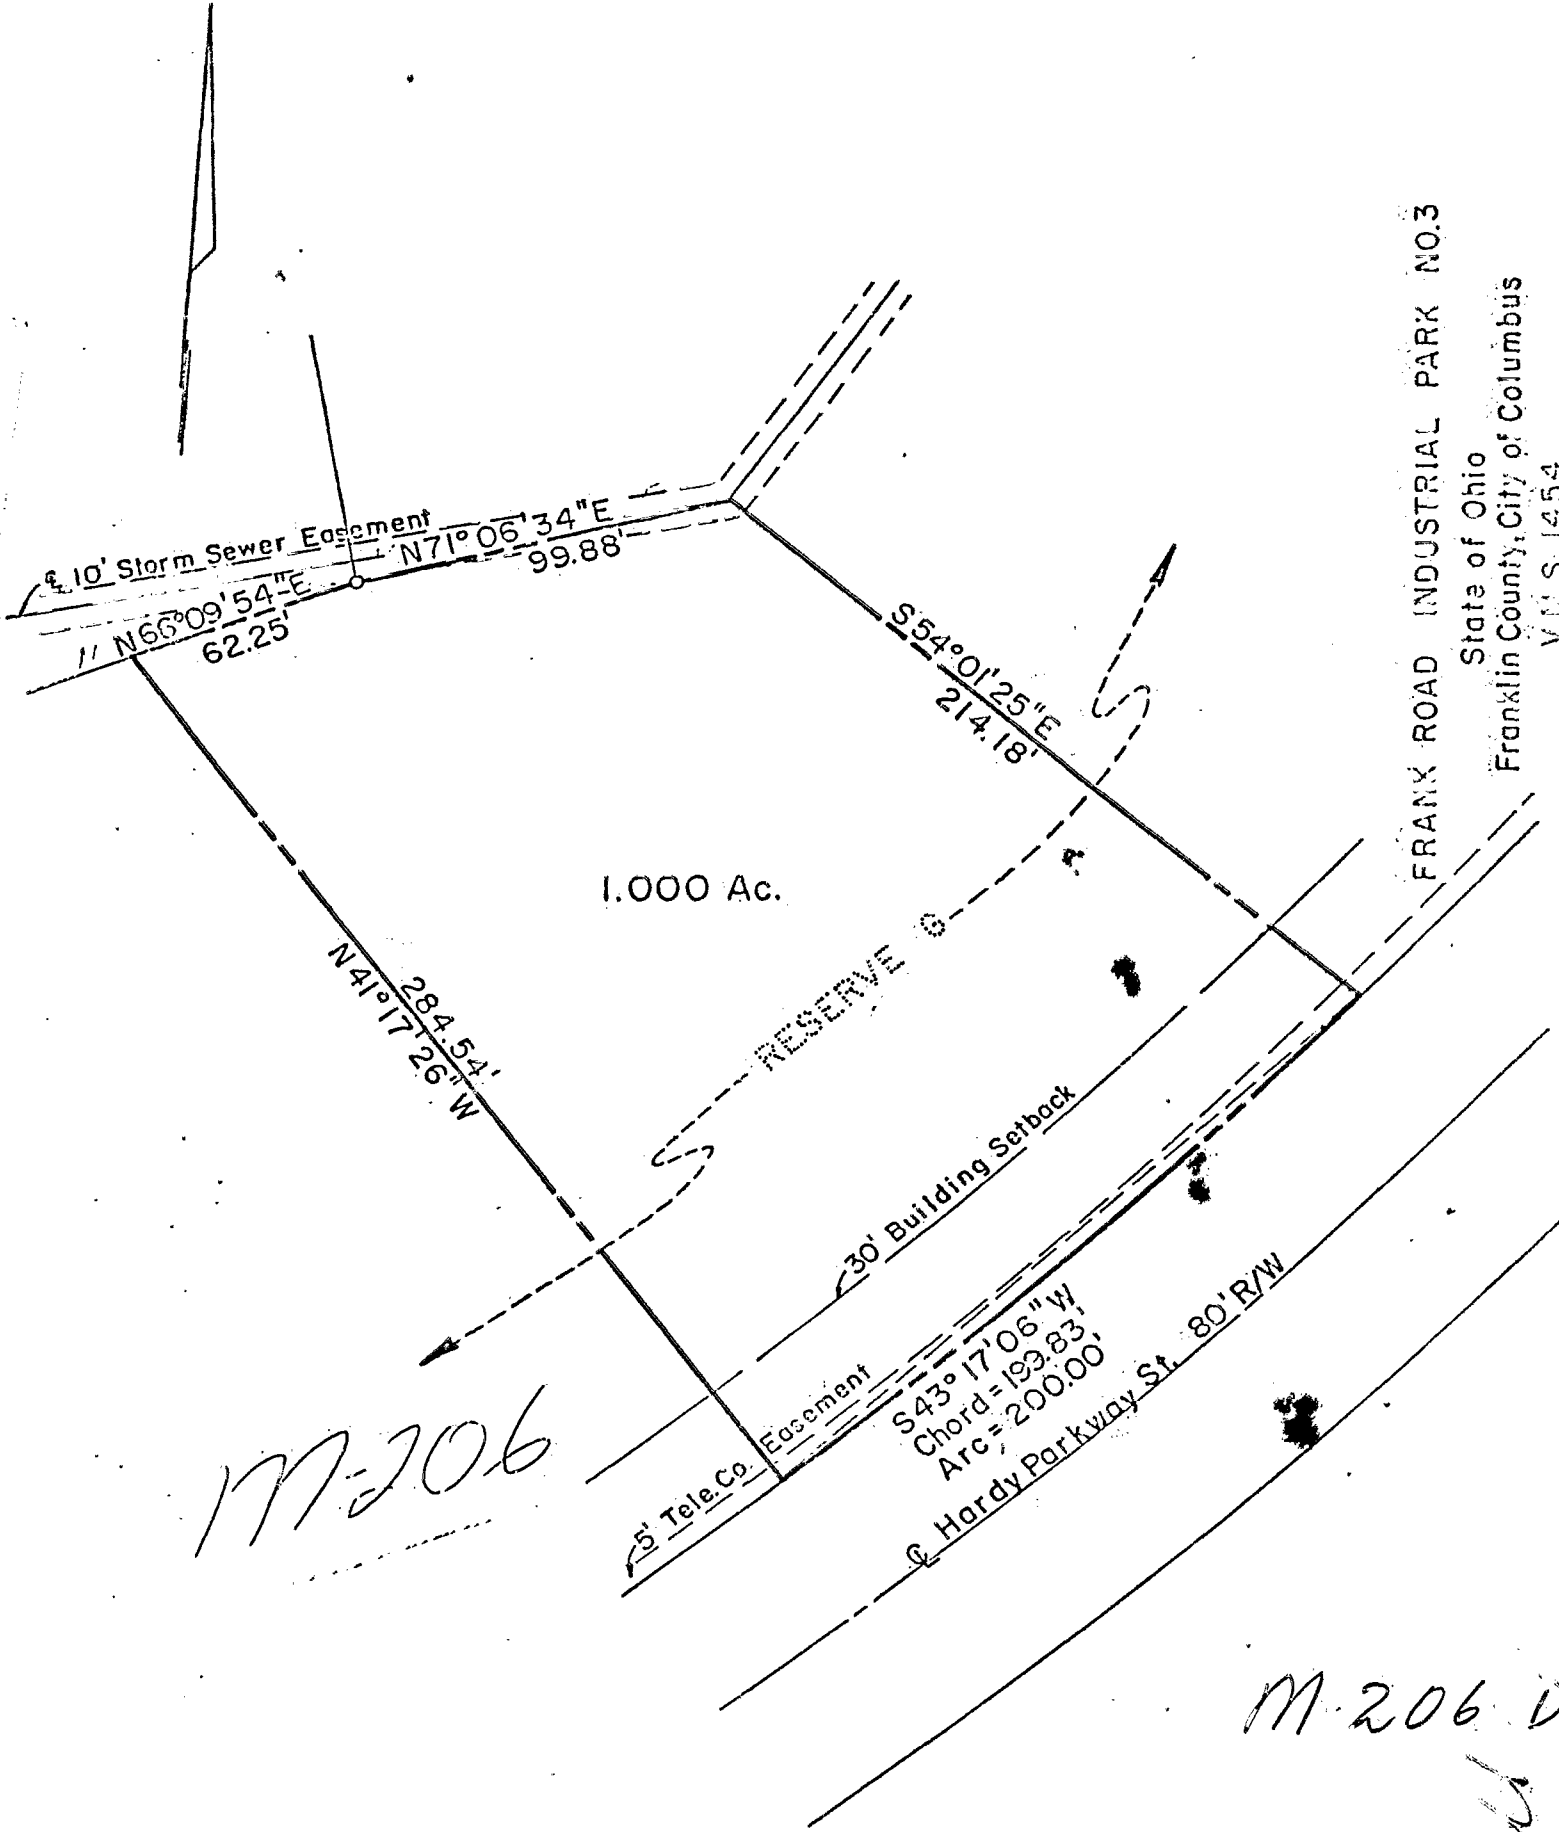

FRANK ROAD INDUSTRIAL PARK NO.3  
State of Ohio  
Franklin County, City of Columbus  
V.L.S. 1454

M-206

M-206 D

M-206-1454

This is to certify that this is a true and accurate plat of a Survey made by me for and at the instance of Frank Road Industrial Park Inc.

JONES-STUCKEY, LTD.  
Civil Engineers

Reg. Surveyor No. 4992

Dec. 1974