

MYERS SURVEYING Co.

2740 East Main Street, Columbus 9 (Bexley), Ohio

FRANKLIN TWP.
D-21-B

BEING 0.174 AC. OUT OF A 5 AC. TRACT (D.B. 831, P.484), IN SURVEY # 717, V.M. LANDS, FRANKLIN TWP., FR. CO., OHIO

FOR
CITIZENS SAVINGS & LOAN
AND/OR
TITLE INS. CO. INVOLVED


() 21-B

D.B. 2667 Page 606

Scale 1" = 20'

Franklin Co. Rec. Off.

4-29-66

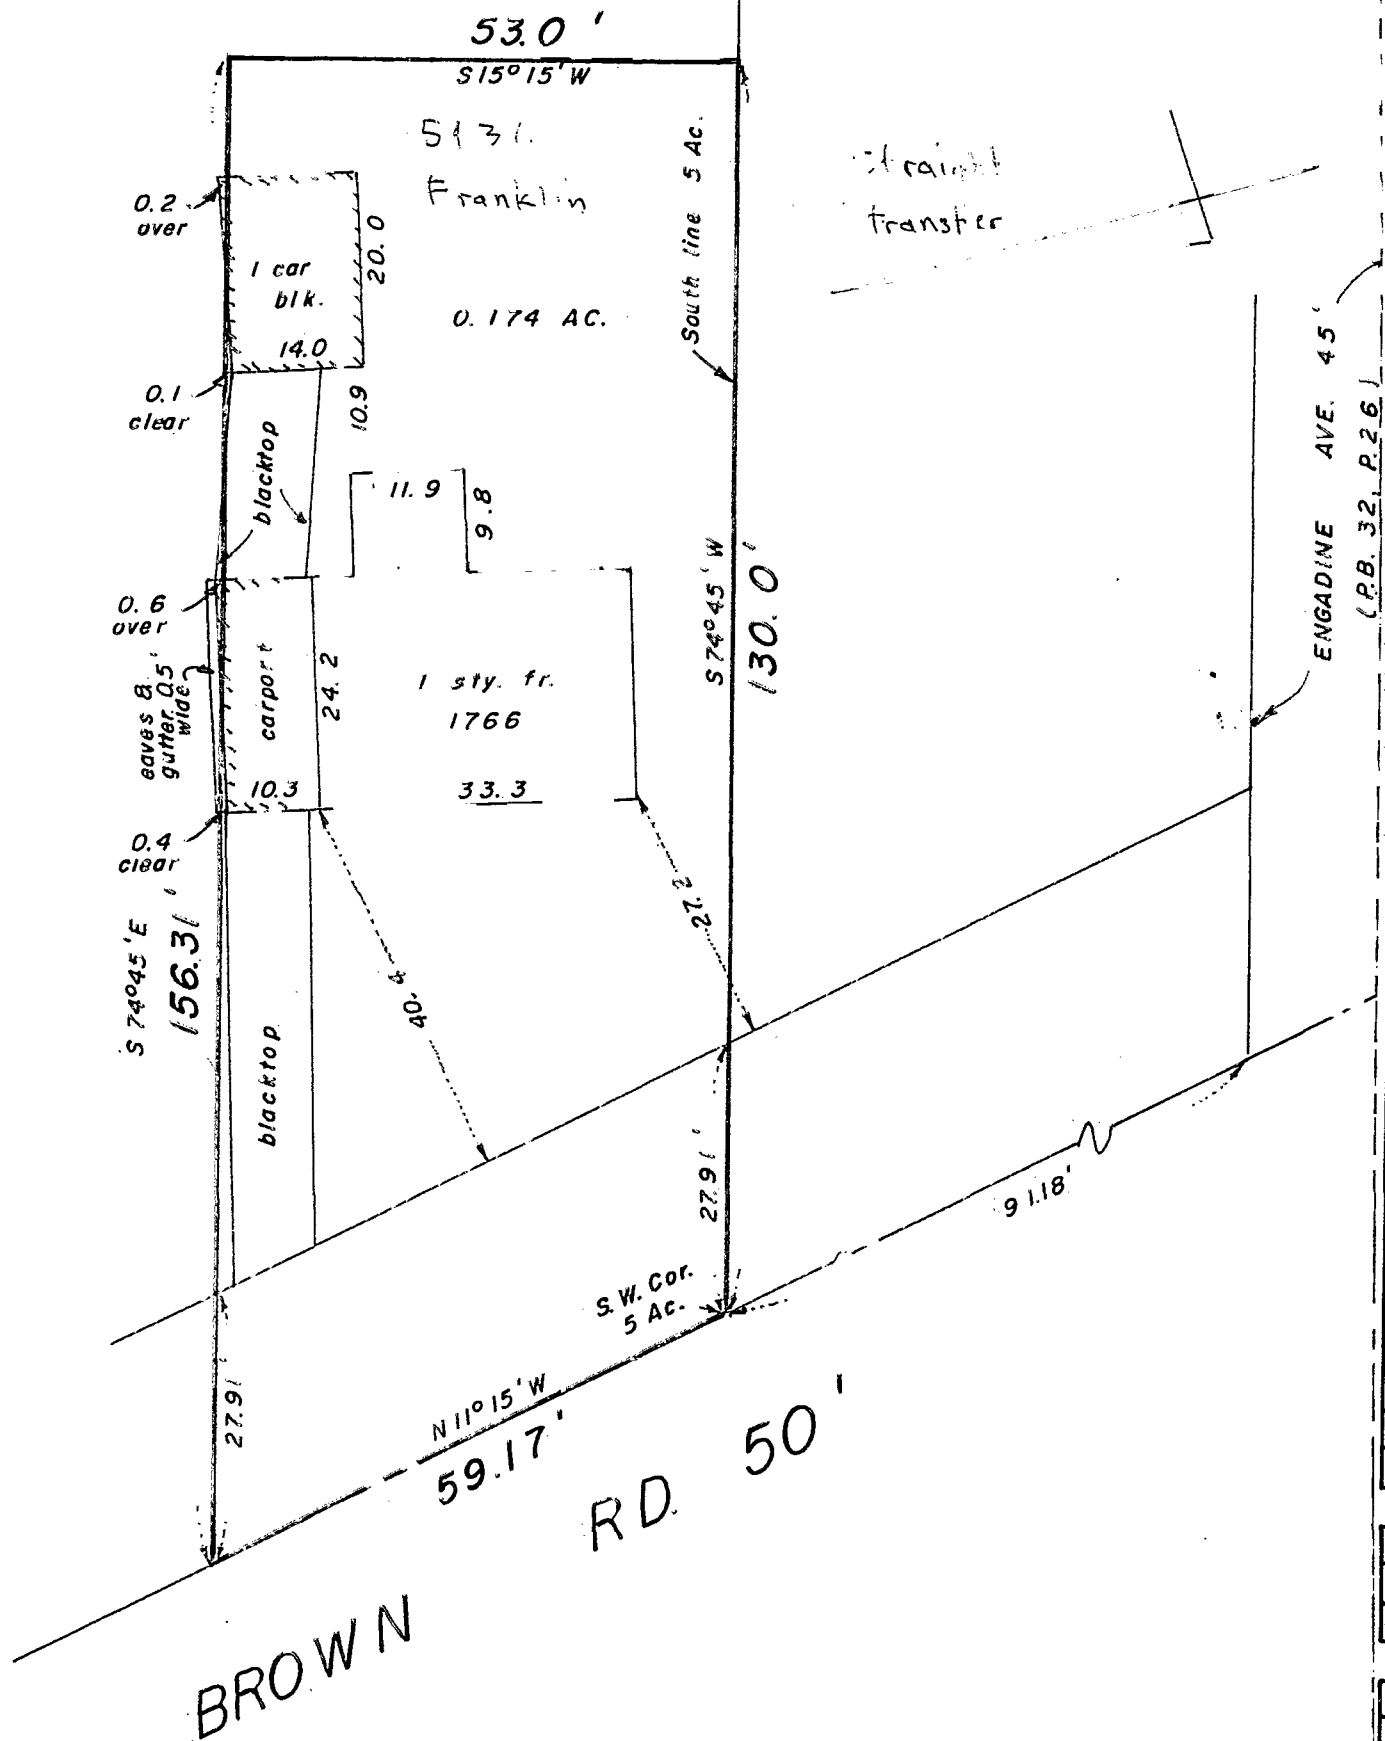

03
02
01
00
99
98
D. 606975

We hereby certify that the foregoing plat was prepared from an actual survey of the premises. No side line of principal building is less than dimension shown. Iron pins not set unless indicated thus -0-. For Mortgage Loan & Title Insurance purposes only.

MYERS SURVEYING Co.
BY *[Signature]*
Registered Surveyor

CAMPBELL