

181406950


SURVEYED PLAT

M-206-D

M-206-D

○ - Denotes iron Pins  
Scale 1" = 100'

Total Acreage 0.903 Ac.

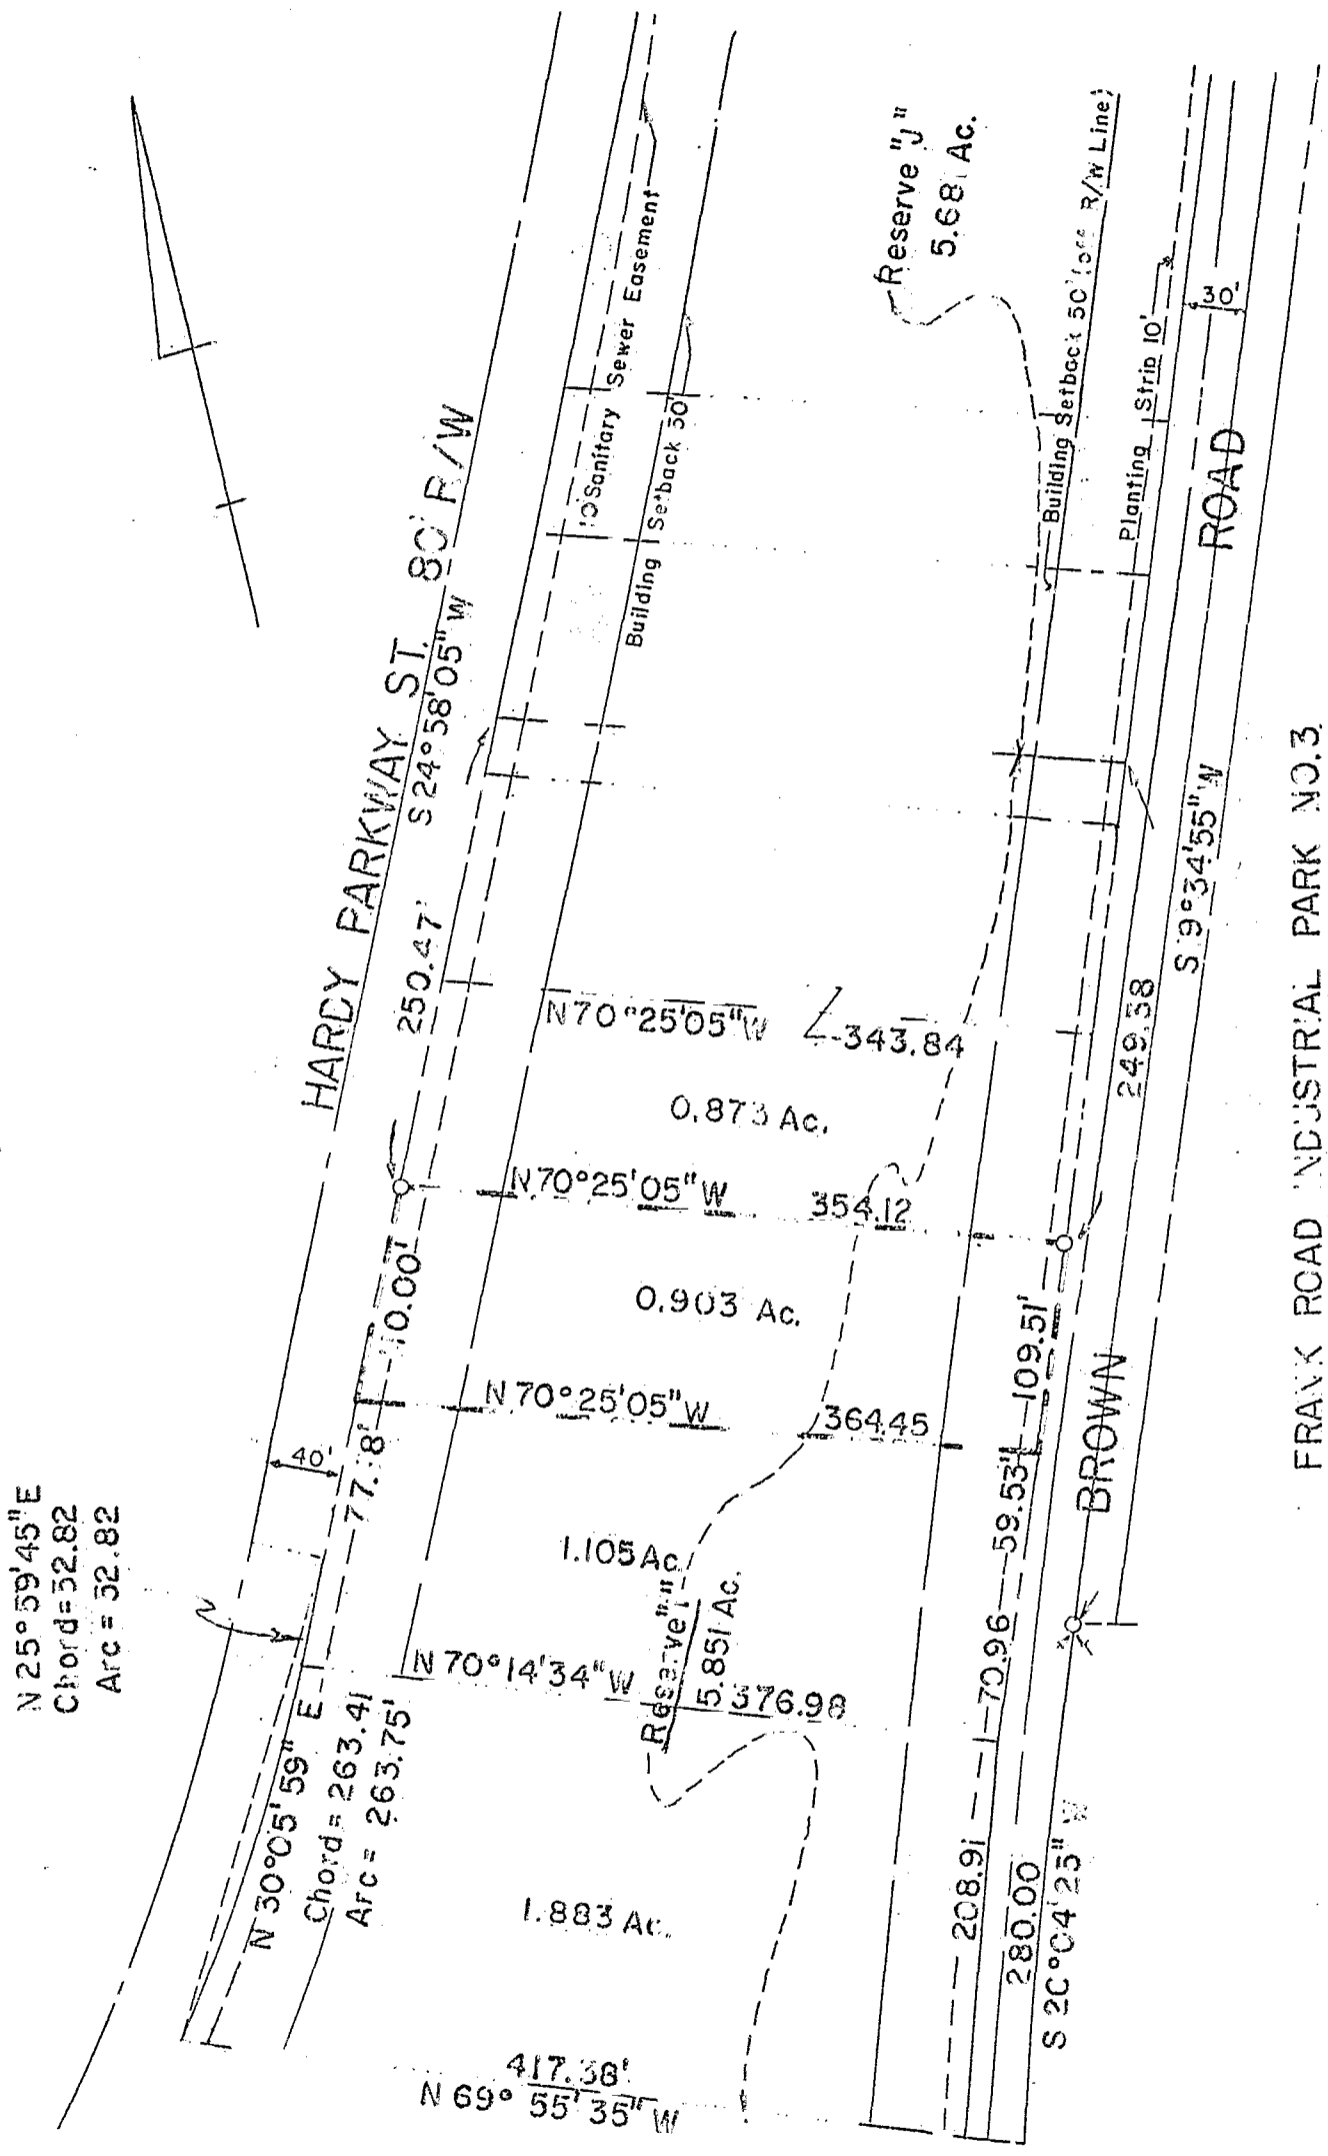

FRANK ROAD INDUSTRIAL PARK NO.3

State of Ohio  
Franklin County, City of Columbus  
V.W.S. 1454

This is to certify that this is a true and accurate plat of a Survey made by [Name] and at the instance of Frank Road Industrial Park Inc.

JONES-STUCKEY, LTD.  
CIVIL ENGINEERS

Reg. Surveyor No. 1099

March 1974

M-206-D