

218503975

Harmon Surveying Company

1766 Columbus Road S.W. (State Rt. 16) ~ Granville, Ohio 43023 (614) 587-2989

BOUNDARY SURVEY



FOR: DAVE GREGORY

Job Number - 1089D

DATE: 03/12/96

SYMBOL LEGEND

- 3/4" IRON PIPE FOUND
- RAILROAD SPIKE SET
- ▲ SURVEY NAIL SET
- ⊙ STATE MONUMENT BOX
- 3/4" IRON PIPE SET

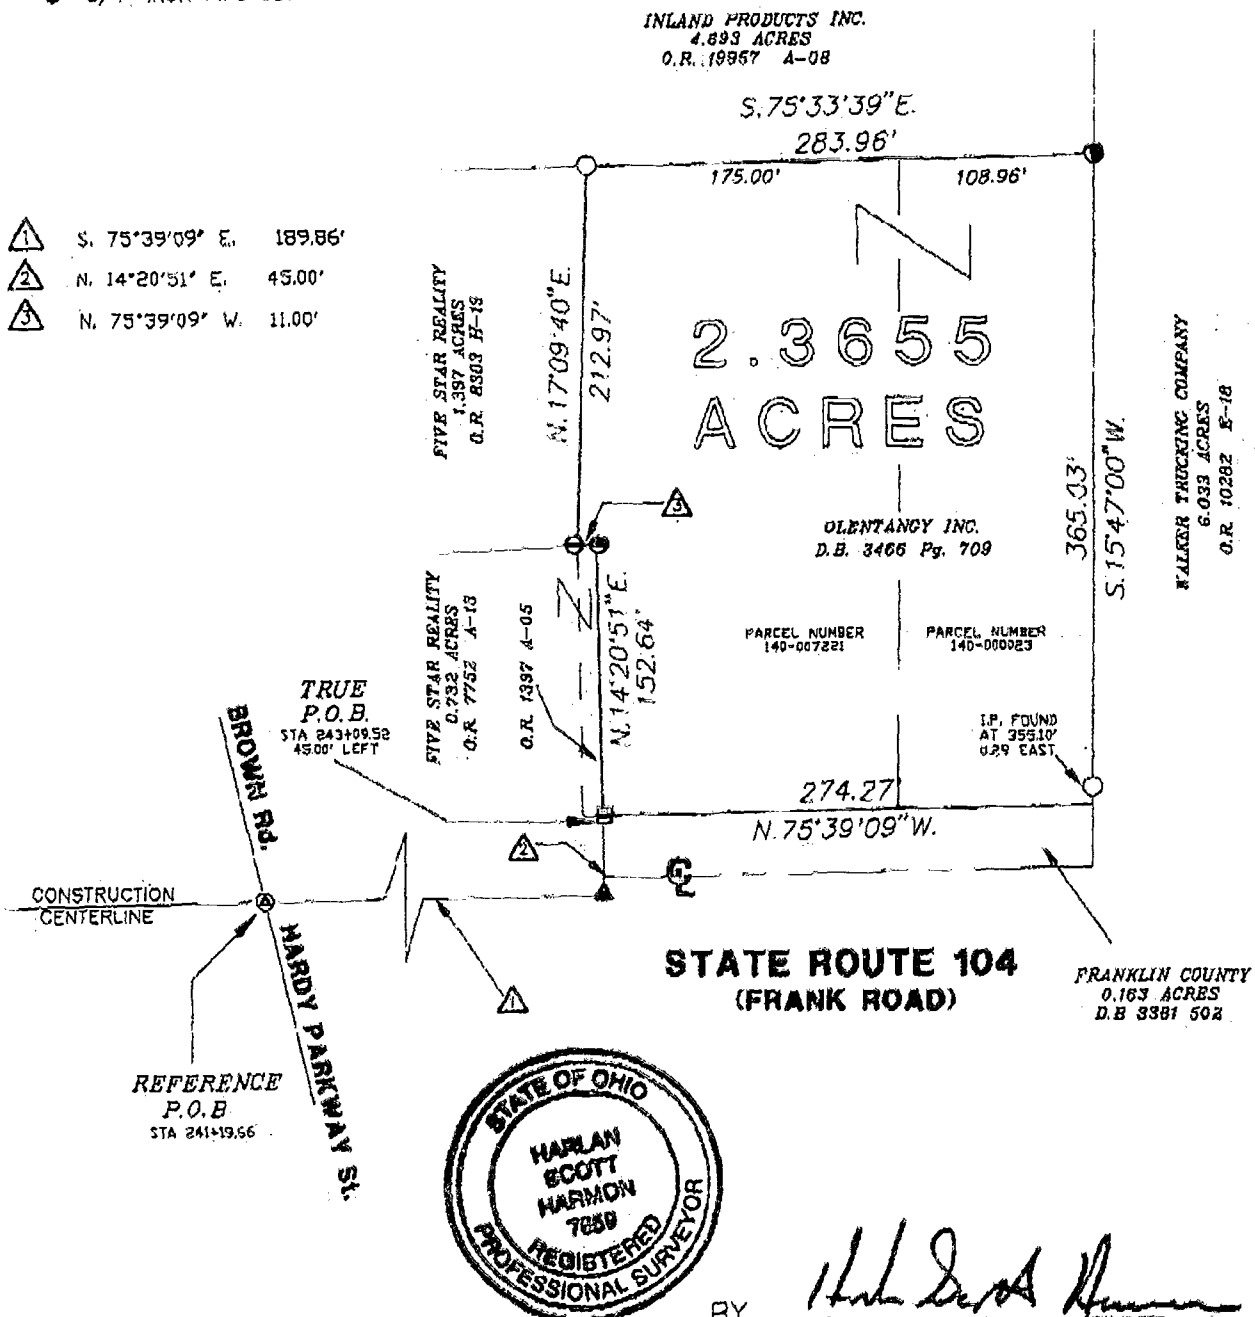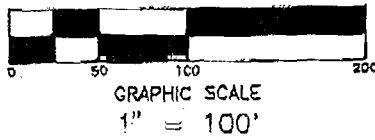

- ① S. 75°39'09" E. 189.86'
- ② N. 14°20'51" E. 45.00'
- ③ N. 75°39'09" W. 11.00'



BY Harlan Scott Harmon
 Professional Surveyor #7659
 HARLAN SCOTT HARMON

BEARINGS ARE BASED ON THE CONSTRUCTION CENTERLINE OF STATE ROUTE 104, AS BEING S. 75°39'09" E., AS SHOWN ON A ODOT CENTERLINE SURVEY MARKED "FRANK ROAD, COUNTY ROAD #125, SECTION A", DATED FEBRUARY 7th, 1973, PAGE 1/30 ALSO MARKED 126/165, AND PAGE 23/30 ALSO MARKED 148/155. THIS PLAT IS BASED ON AN ACTUAL FIELD SURVEY BY THE HARMON SURVEYING CO. IN MARCH 1996. ALL IRON PIPES SET ARE 3/4" O.D. x .30", WITH ID. CAP MARKED "HARMON PS #7659".

SITUATED IN THE STATE OF OHIO, COUNTY OF FRANKLIN, TOWNSHIP OF FRANKLIN, AND IN V.M.S. #717, AND BEING THE SAME TRACT AS RECORDED IN D.B. 3466 PAGE 709.

GRANVILLE
 8-856-975