

JERRY A. MALOTT SURVEYING Co.


6810 East Main Street ~ Suite 101, Reynoldsburg, Ohio 43068 (614) 577-0957

FOR:

PET CREMATION SERVICES, INC.

PROPOSED LOT SPLIT

1996-APRIL-PET

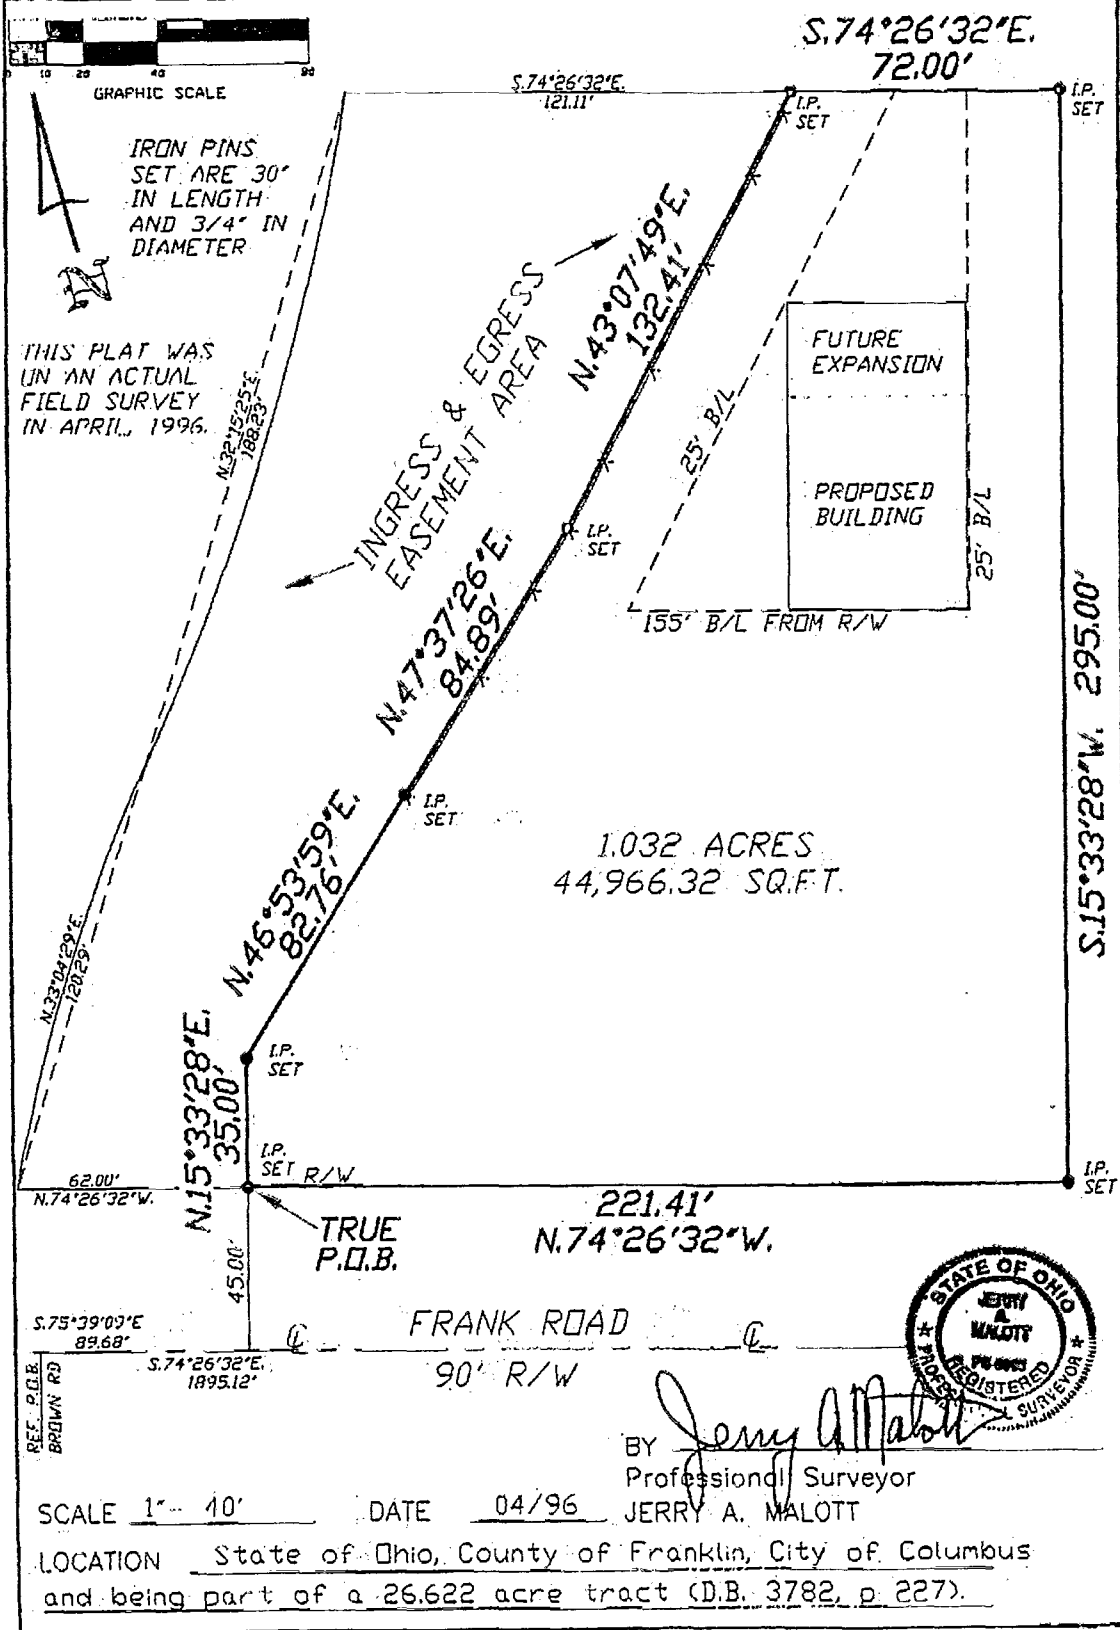

FRANKLIN
8,856 975