


21071-F  
 92856575  
 92856950

MARION TWP.

0-550

4  
 STREET  
 HIGH  
 S.

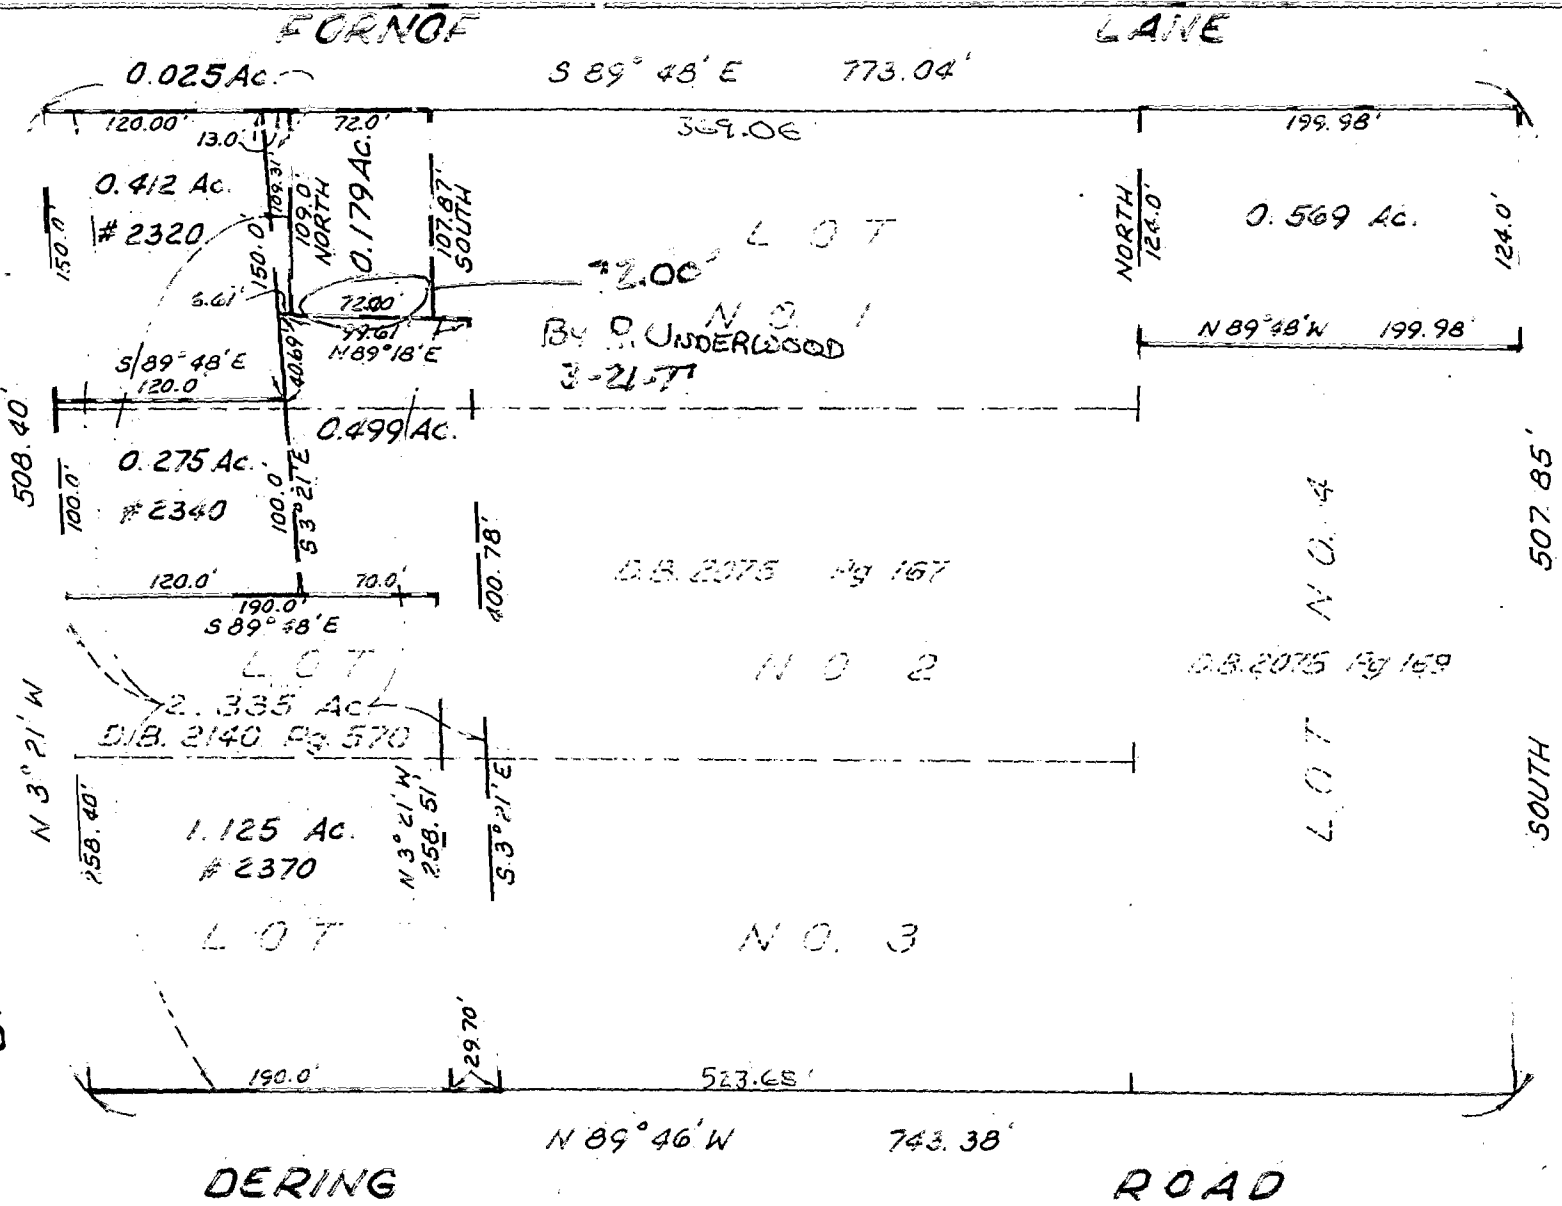

PARTS OF LOTS NOS. 1, 2, 3 & 4  
 NATHANIEL MERION'S SUB. OF PT. OF SEC. 4, T-4, R-22  
 CONGRESS LANDS, CITY OF COLUMBUS, FRANKLIN CO.  
 STATE OF OHIO

FOR  
**PETER FORNOF & SON CO.**

THE JENNINGS-LAWRENCE CO.  
 Civil Engineers and Surveyors  
 555 Buttes Avenue  
 Columbus 15, Ohio

By Roy T. Underwood  
 Registered Surveyor

SCALE: 1" = 100'

2180 120 078 067 E OF H 164 ST. 1977 055 030 12072