
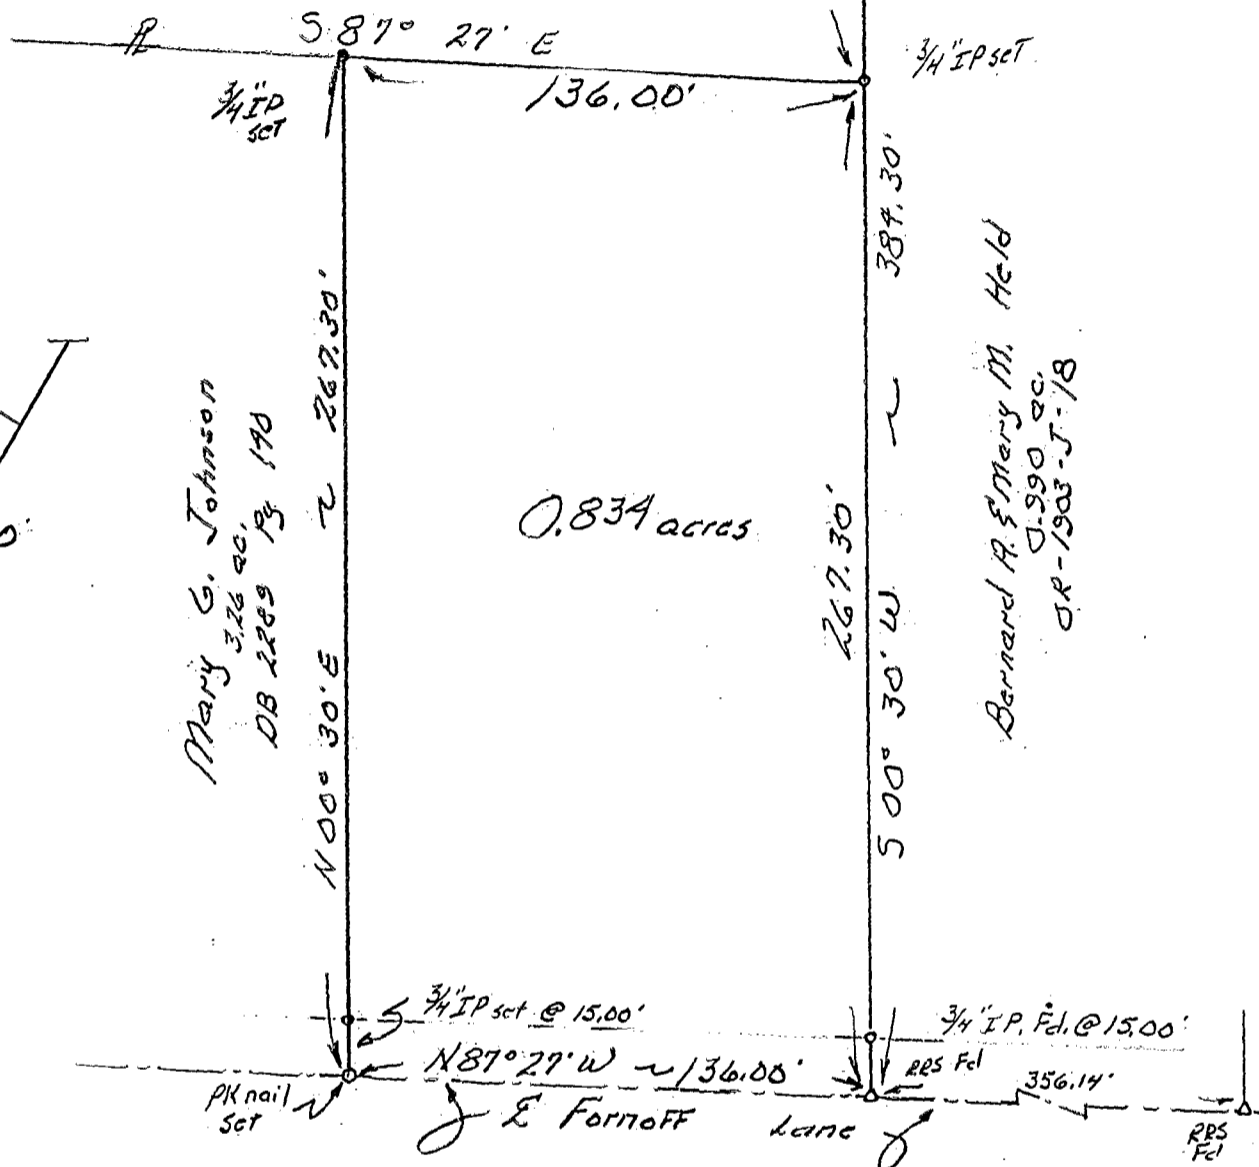


Ohio Wire Spring Co.  
2.055 ac.  
O.R. 5010-6-02


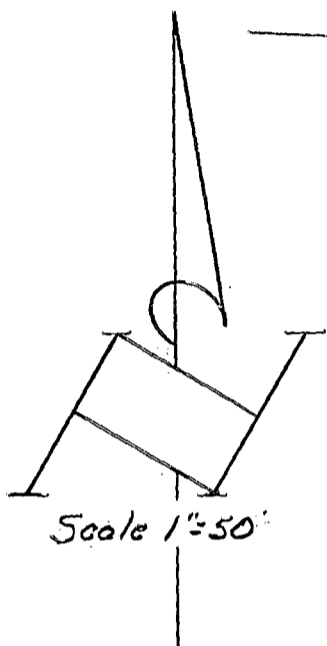


Survey of 0.834 acres  
in Sec. 4, Twp. 4, Rge. 22,  
in the City of Columbus,  
Franklin Co., Ohio:  
For

Ohio Wire Spring Company

**Louis F Haines**

354 Kessler Street  
Groveport, Ohio 43125  
Phone 837-2181

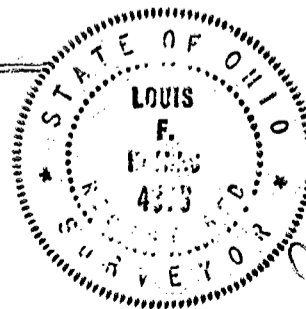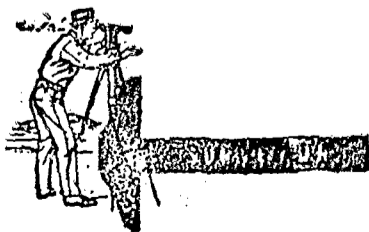

I HEREBY CERTIFY THE PLAT SHOWN HEREON  
IS CORRECT AS SURVEYED BY US.  
DATE: APRIL 15, 1986  
SIGNED: Louis F. Haines

82856925

MAPLE TWP. 4