

183101025

MYERS SURVEYING CO.

2740 East Main Street, Columbus 9 (Bexley), Ohio


K 52

PARTITION OF PART OF LOT 504, ESTATE OF WM. MERION DEC. D. (P.B. 17, P. 256), PART OF A VACATED ALLEY, (ORD. # 26182), AND ALL OF A TRACT (66' X 90'), COLUMBUS, OHIO
FOR
BRAD SALT, REALTORS

P.B. Page
Scale 1" = 20'

Franklin Co. Rec. Office
6 11 73

WAGER ST. 50'

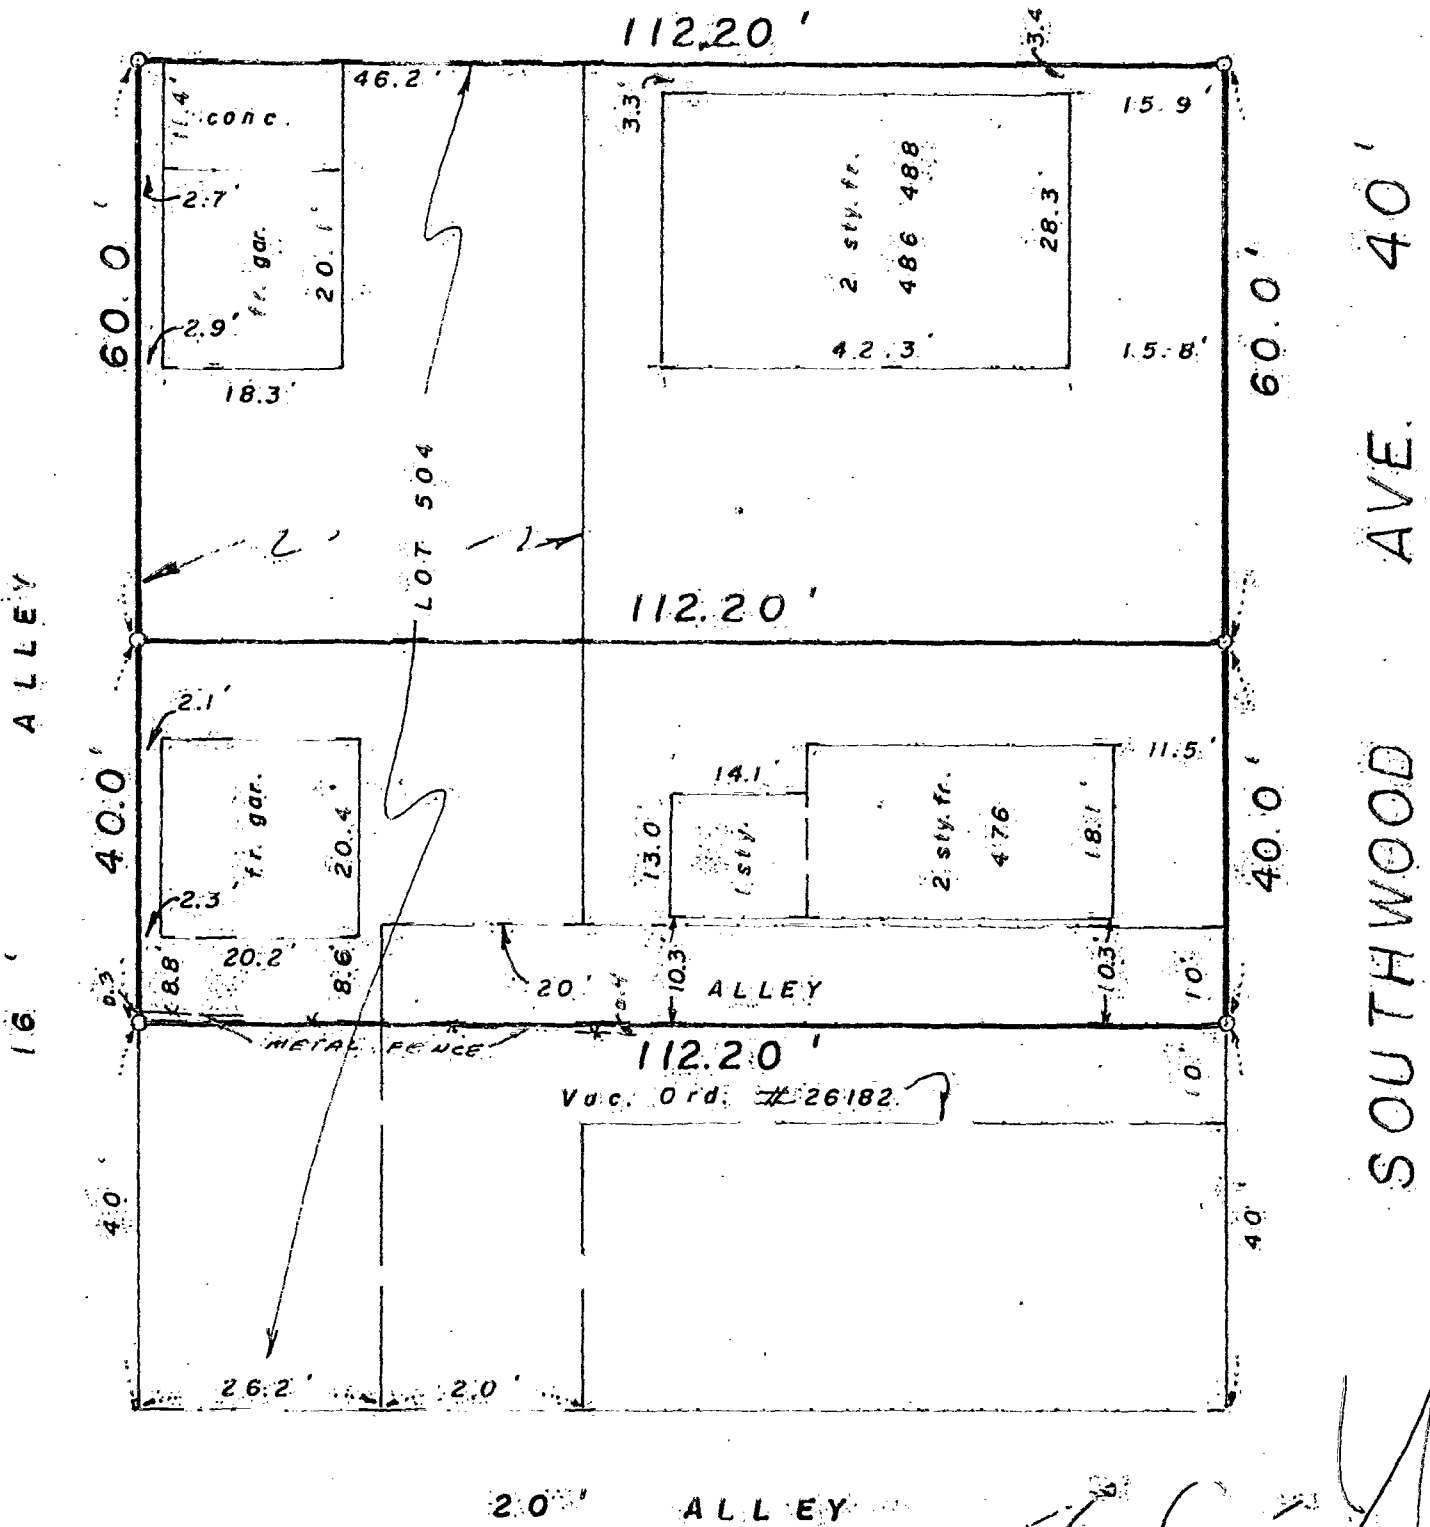

We hereby certify that the foregoing plat was prepared from an actual survey of the premises. No side line of principal building is less than dimension shown. Iron pins not set unless indicated thus: -0-

MYERS SURVEYING CO.

Albert Myers Jr.
Registered Surveyor