


CERTIFICATE OF SURVEY
 Columbus, Ohio September 9, 1916


75-11-20

I hereby certify that I have made a survey of the premises described in the NE 1/4 of the same sec. 120 in D. B. 1381, 11, 12 1/2, 13, 14, 15, Franklin County, Ohio, owned by Charles B. Bennerman, situated in the 1/2 of Donald's Tract, more particularly shown in the (New City of Columbus), Franklin County, Ohio, sought to be acquired by Chester L. Baker, Jr., and I have found the line land marked firm as shown here on

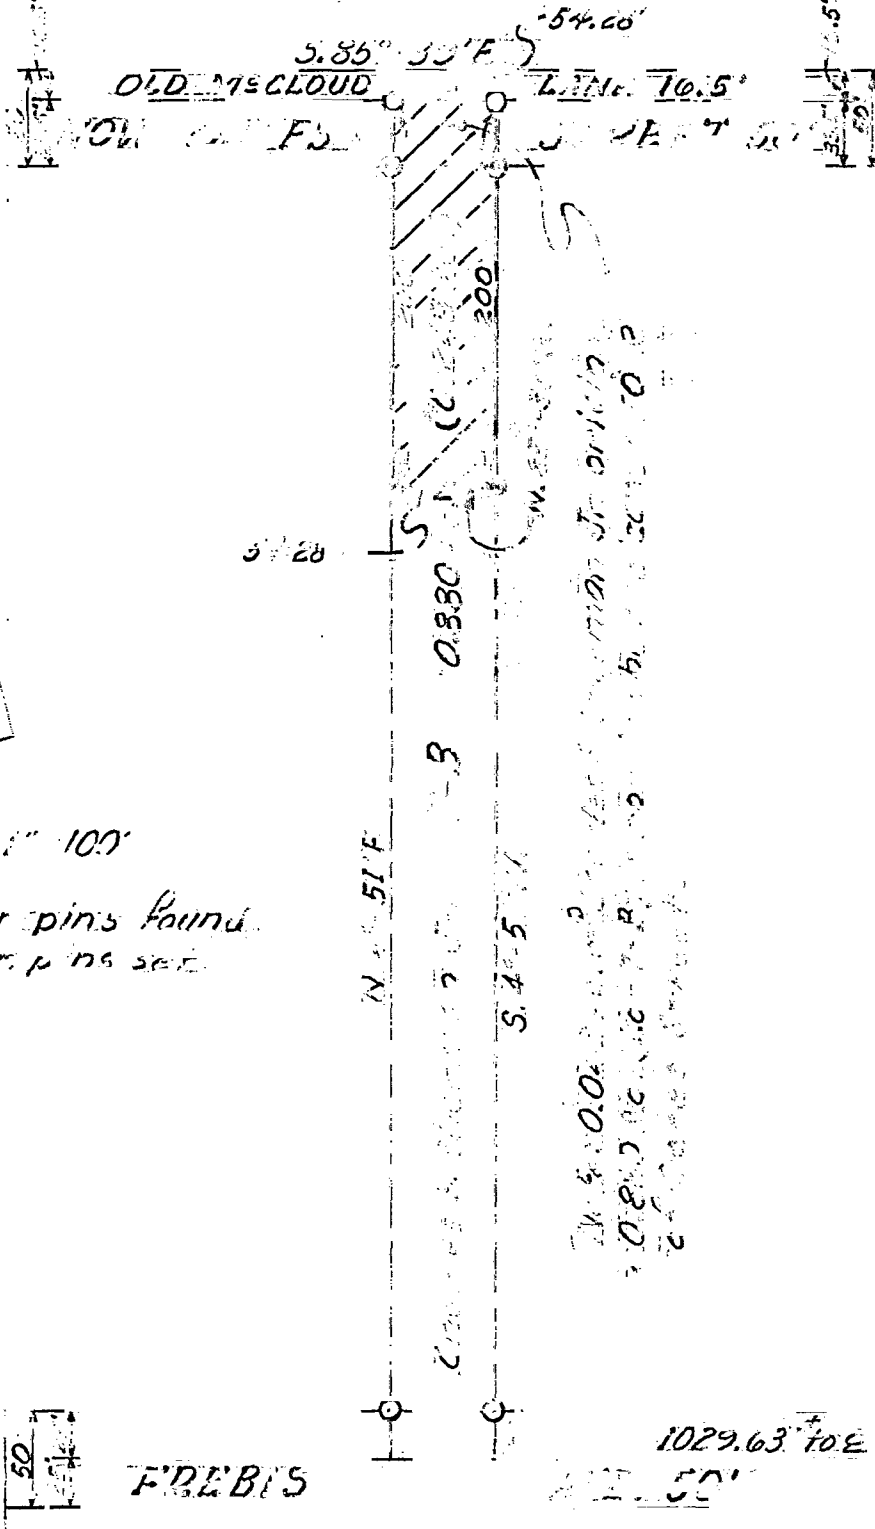

Scale: 1" = 100'

○ Denotes iron pins found.
 □ Denotes iron pins set.

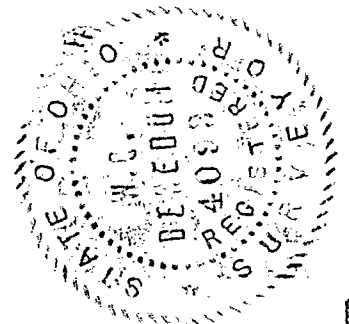

F.D.B.'S

1029.63' to E Fairwood Ave

□ / □ Venores premises surveyed for and premises sought to be acquired by Chester L. Baker, Jr. at his request (0.249 Ac. out of original 0.880 Ac.)

Registered Surveyor No. 5 4093

Wilbert C. Benedum
 Wilbert C. Benedum

MARRI

5225