


NORTH
POINT

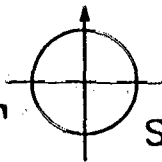


SURVEYING

6202 Outville Road SW
Pataskala, Ohio 43062-9526
Phone (614) 927-2474
Fax - (614) 475-7809

BOUNDARY SURVEY

Situated in the state of Ohio,
County of Franklin, and in the
city of Columbus, and the un-
numbered lot of Bloomfield
Heights (plat book 41, page 21).

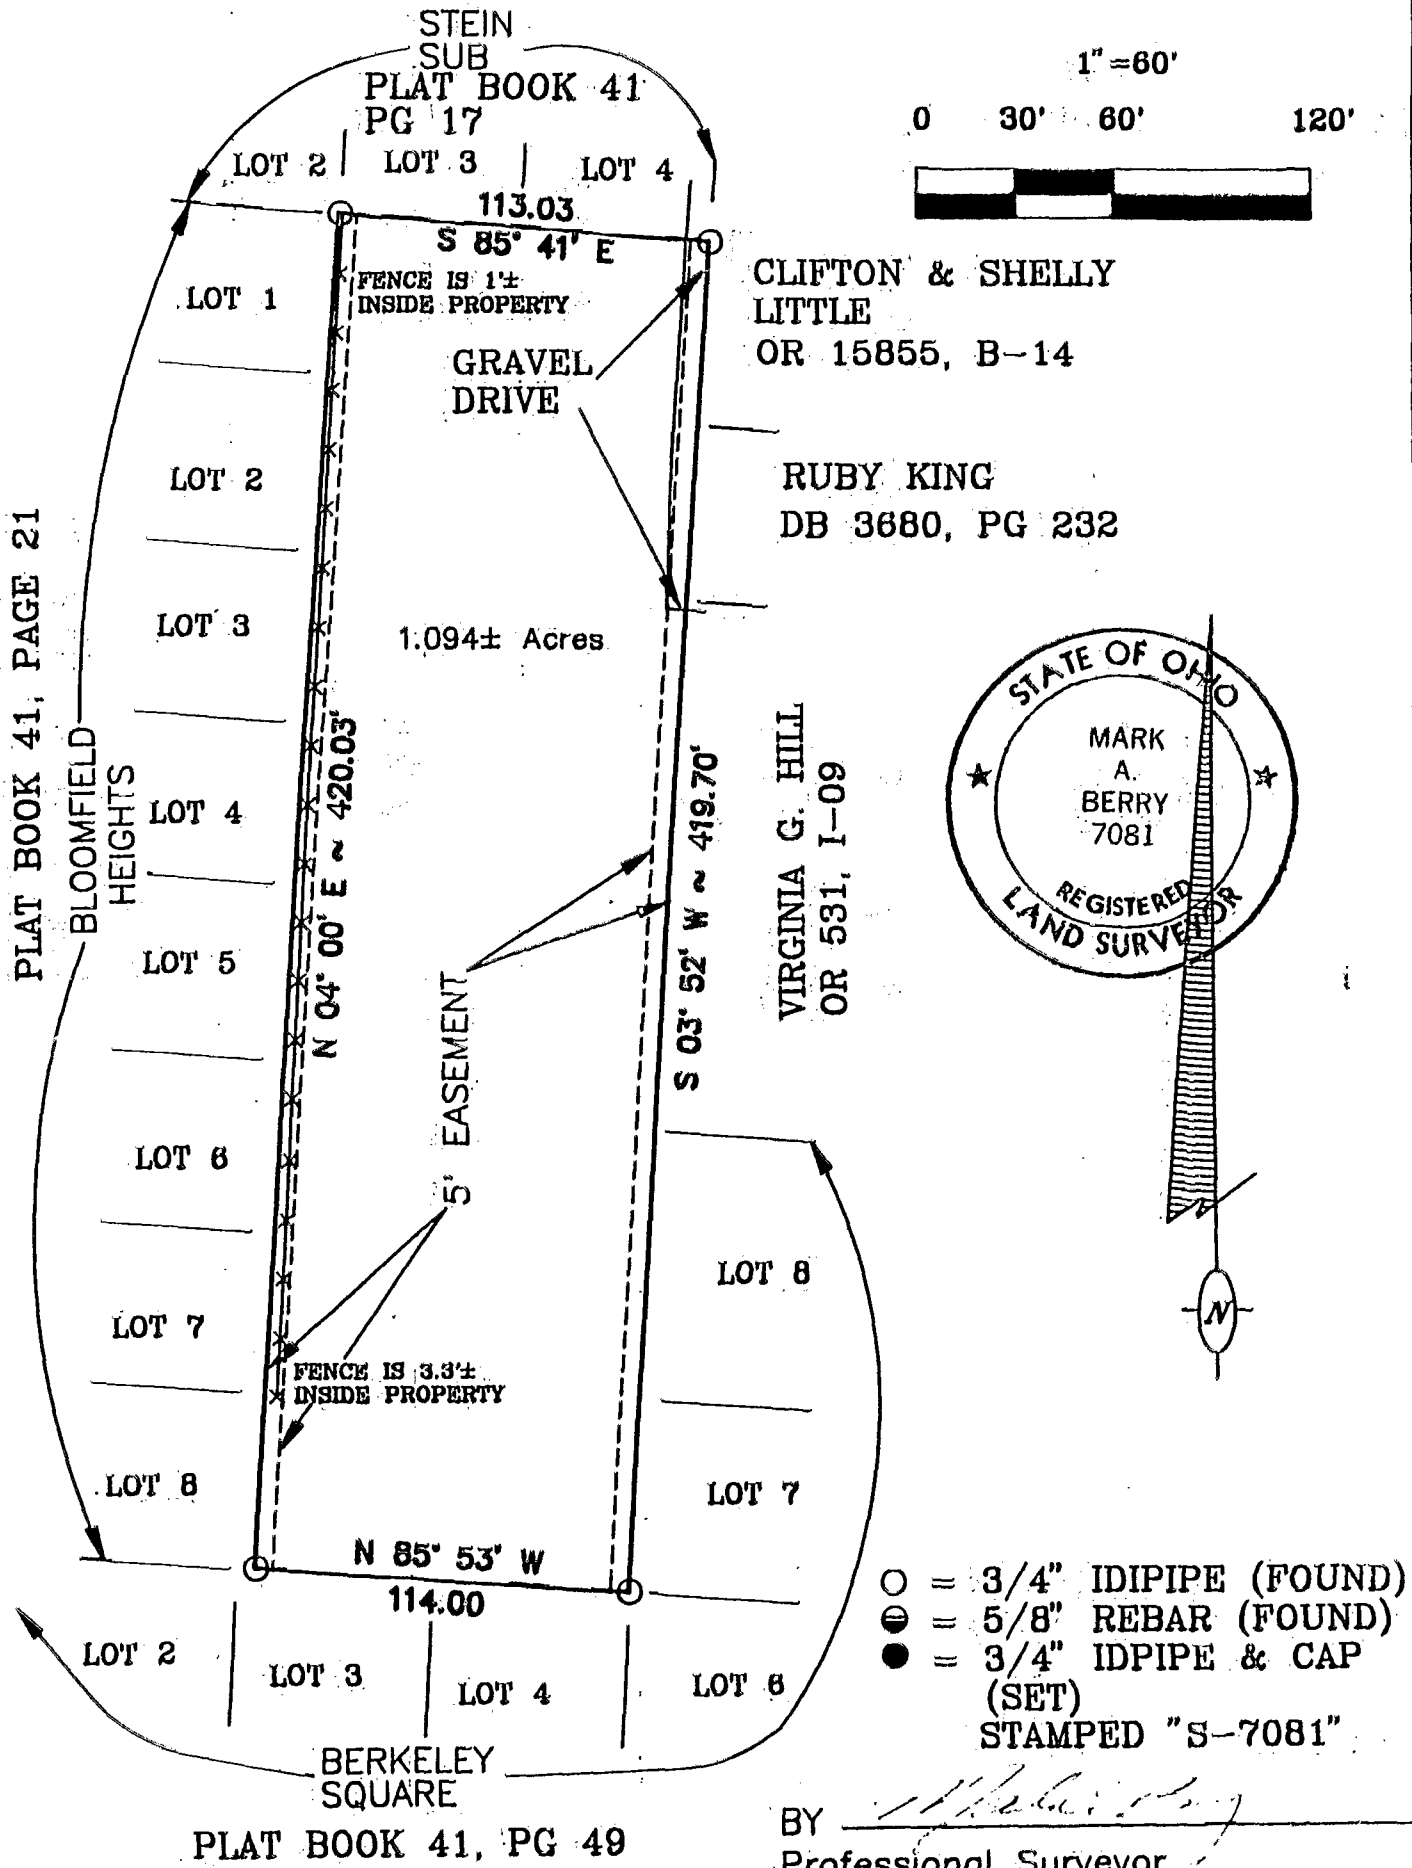

BY Mark A. Berry
Professional Surveyor
MARK BERRY # 7081

DATE 4/91

Bearings for this survey are based on ties made to and the west line of the subject tract being N 04° 00' E.

183857050

183857050