

Myers Surveying Company, Inc.


2740 East Main Street, Columbus 43209 (Bexley), Ohio
614-235-8677 FAX: 614-235-4559

N-16



A Boundary Survey prepared for and certified to:
Elsie Fout

Legal Description: Situated in Ohio, County of Franklin, City of Columbus, Being 0.260 Acres, Being a part of Lots 26 & 27 of Champion Avenue Terrace Addition, Plat Book 20, Page 66

Applicant:
Mailed Address: 875 Jenkins Ave., Columbus, Ohio

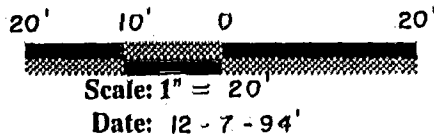

E. JENKINS AVE. 50'

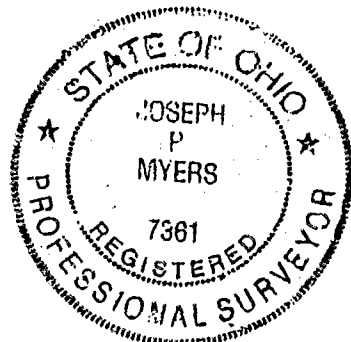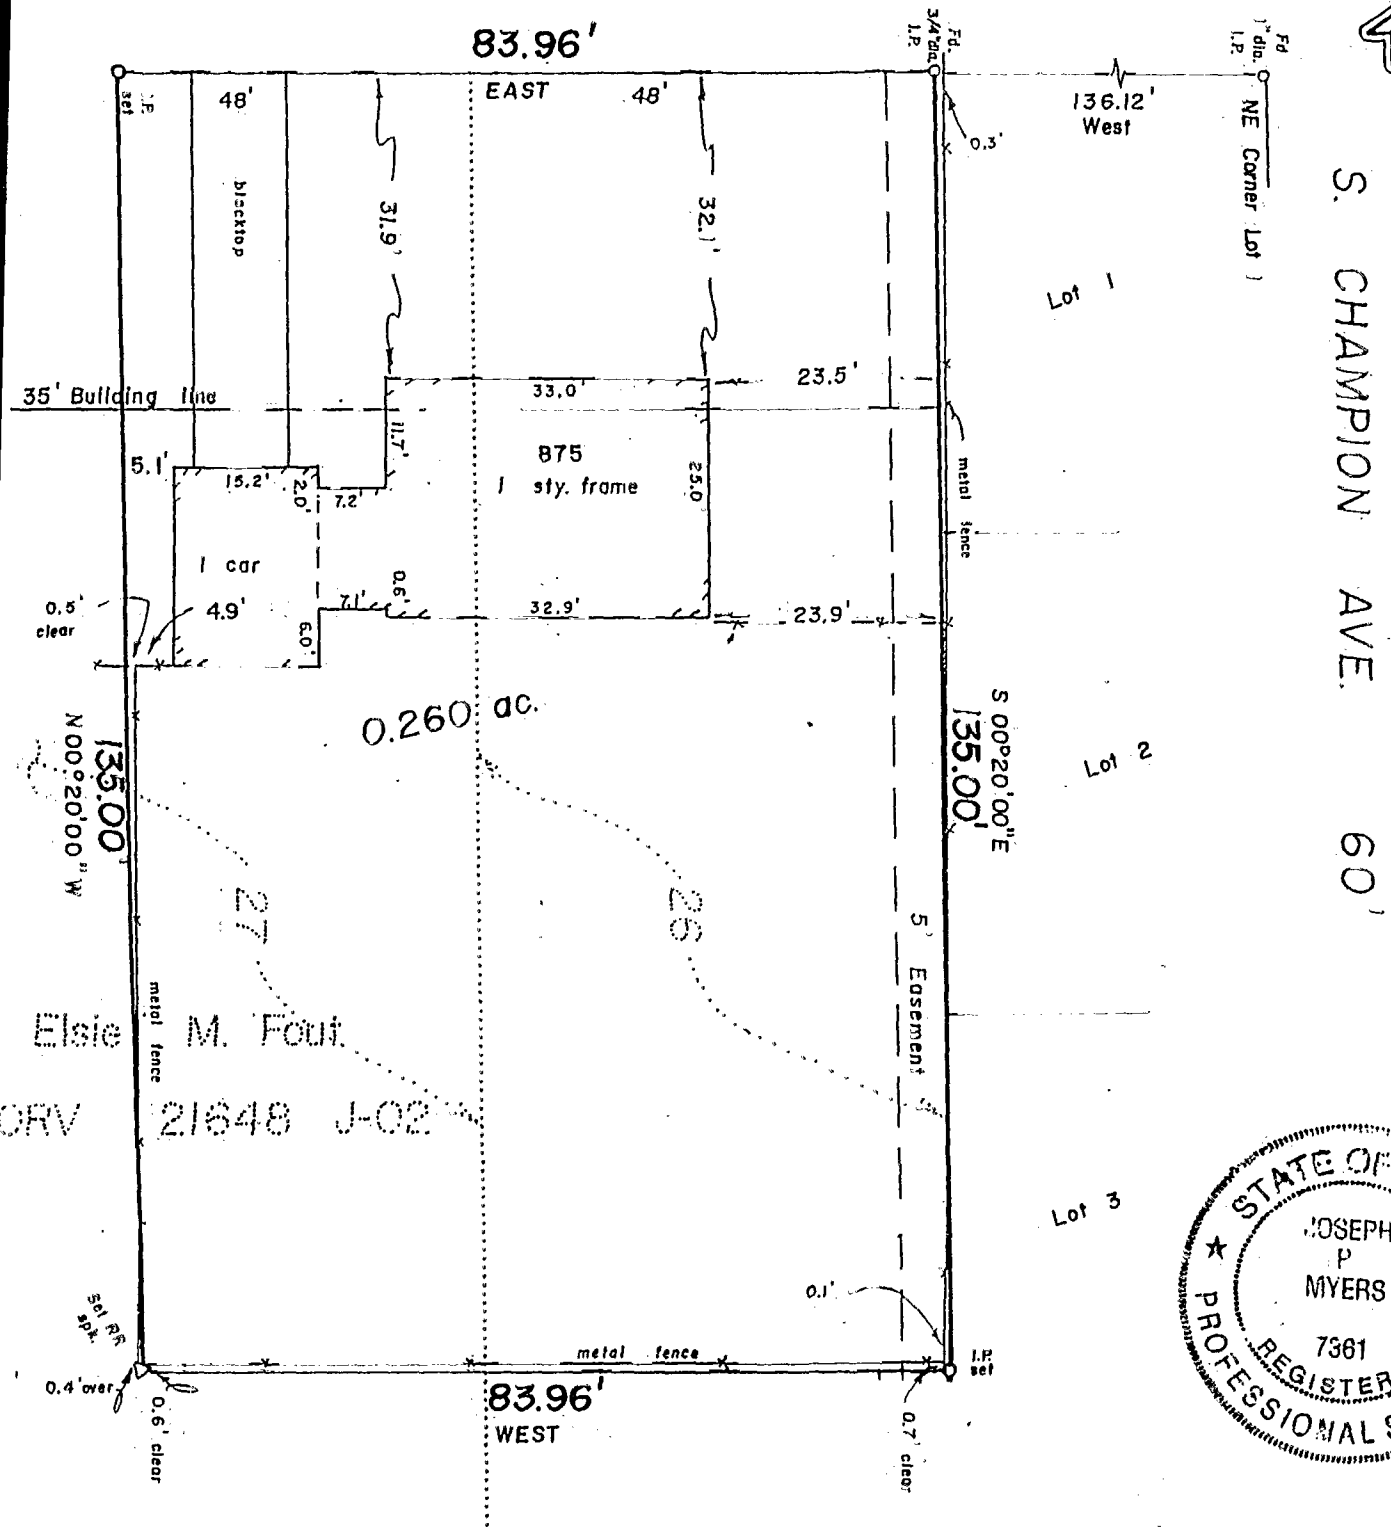

We hereby certify that the foregoing Boundary Survey was prepared from actual field measurements in accordance with Chapter 4733-37 Ohio Administrative Code. Iron pins set are 30"x1" O.D. with an orange plastic plug inscribed "P.S. 6579", unless otherwise noted. Basis of bearing is the southerly line of East Jenkins Avenue assumed EAST.

Myers Surveying Co., Inc.
By *Joseph P. Myers*
Professional Surveyor

MARKED 183 607 025

N-16