

# MYERS SURVEYING CO.

2740 East Main Street, Columbus 9 (Bexley), Ohio

PARTITION OF LOT 5 SAMAR ADD'N. COLUMBUS, OHIO

18385 7025  
18410 7025

FOR


MR. DONALD HOPE

P.B. 27 Page 2:A


Scale 1" = 25'

Franklin Co. Rec. Office

6-15-73

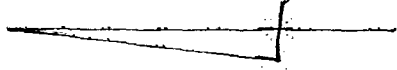

18385-35

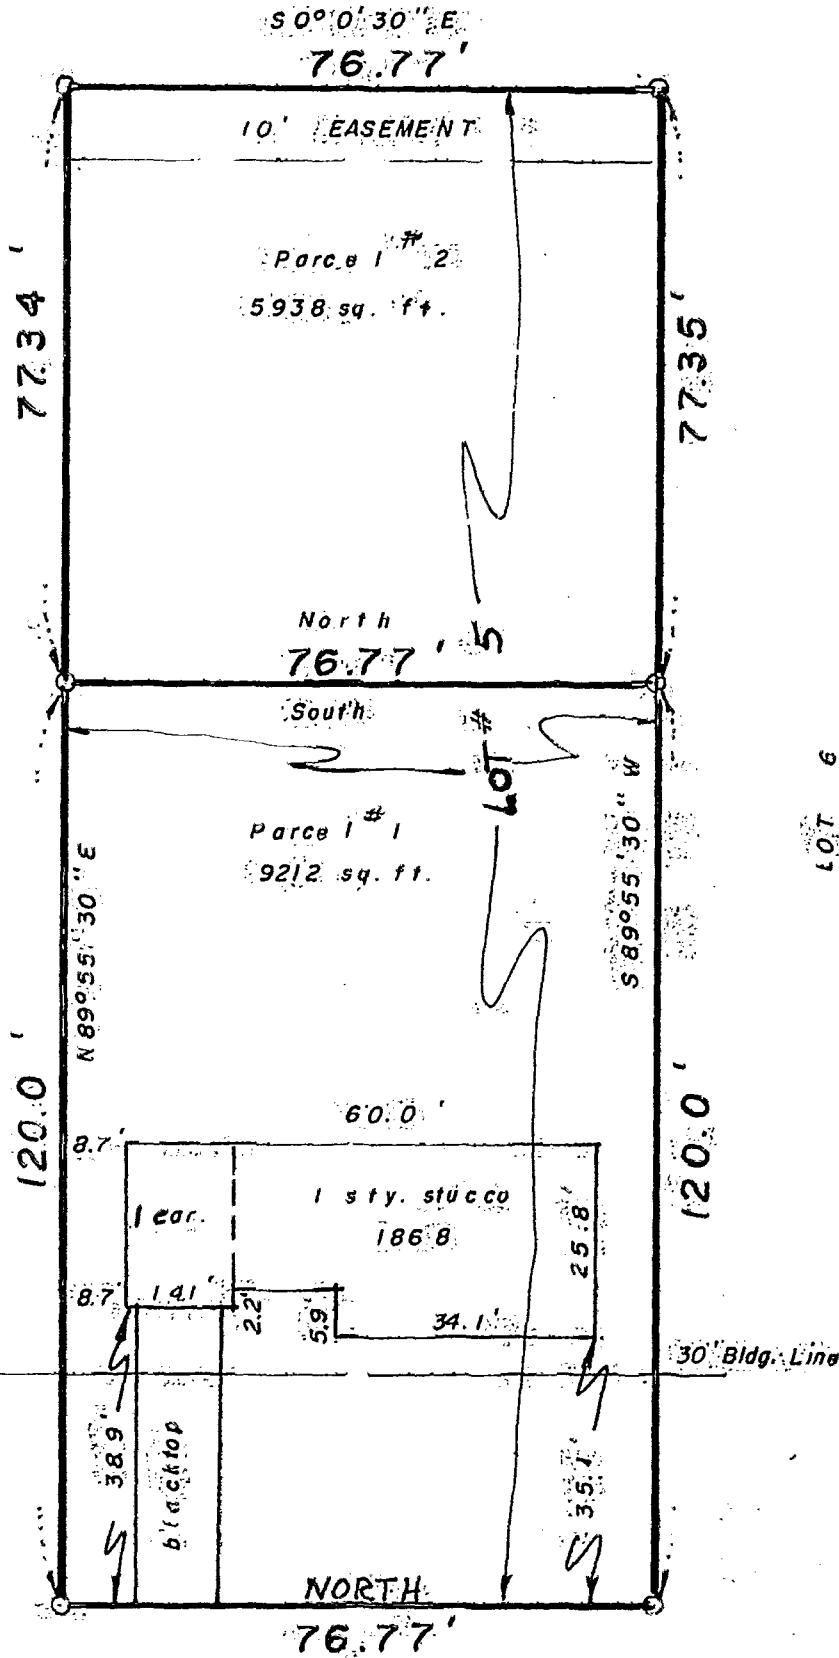

FAIRWOOD AVE.

We hereby certify that the foregoing plat was prepared from an actual survey of the premises. No side line of principal building is less than dimension shown. Iron pins not set unless indicated thus -0-

MYERS SURVEYING CO.

BY Albert H. Anderson  
Registered Sur