


183356450

N 21
0007 02

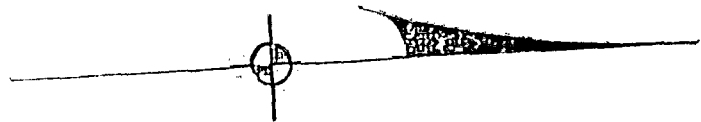


BASIS OF BEARINGS: ASSUMED MERIDIAN

SURVEY OF 1.871 AC. IN RES. "A"
HEIMANDALE SUBDIVISION
(P.B. 7, P. 330 & 331),
COLUMBUS, OHIO, FOR
MR. LLOYD W. BLACK, JR.

SCALE: 1" = 120'

JUNE 22, 1988

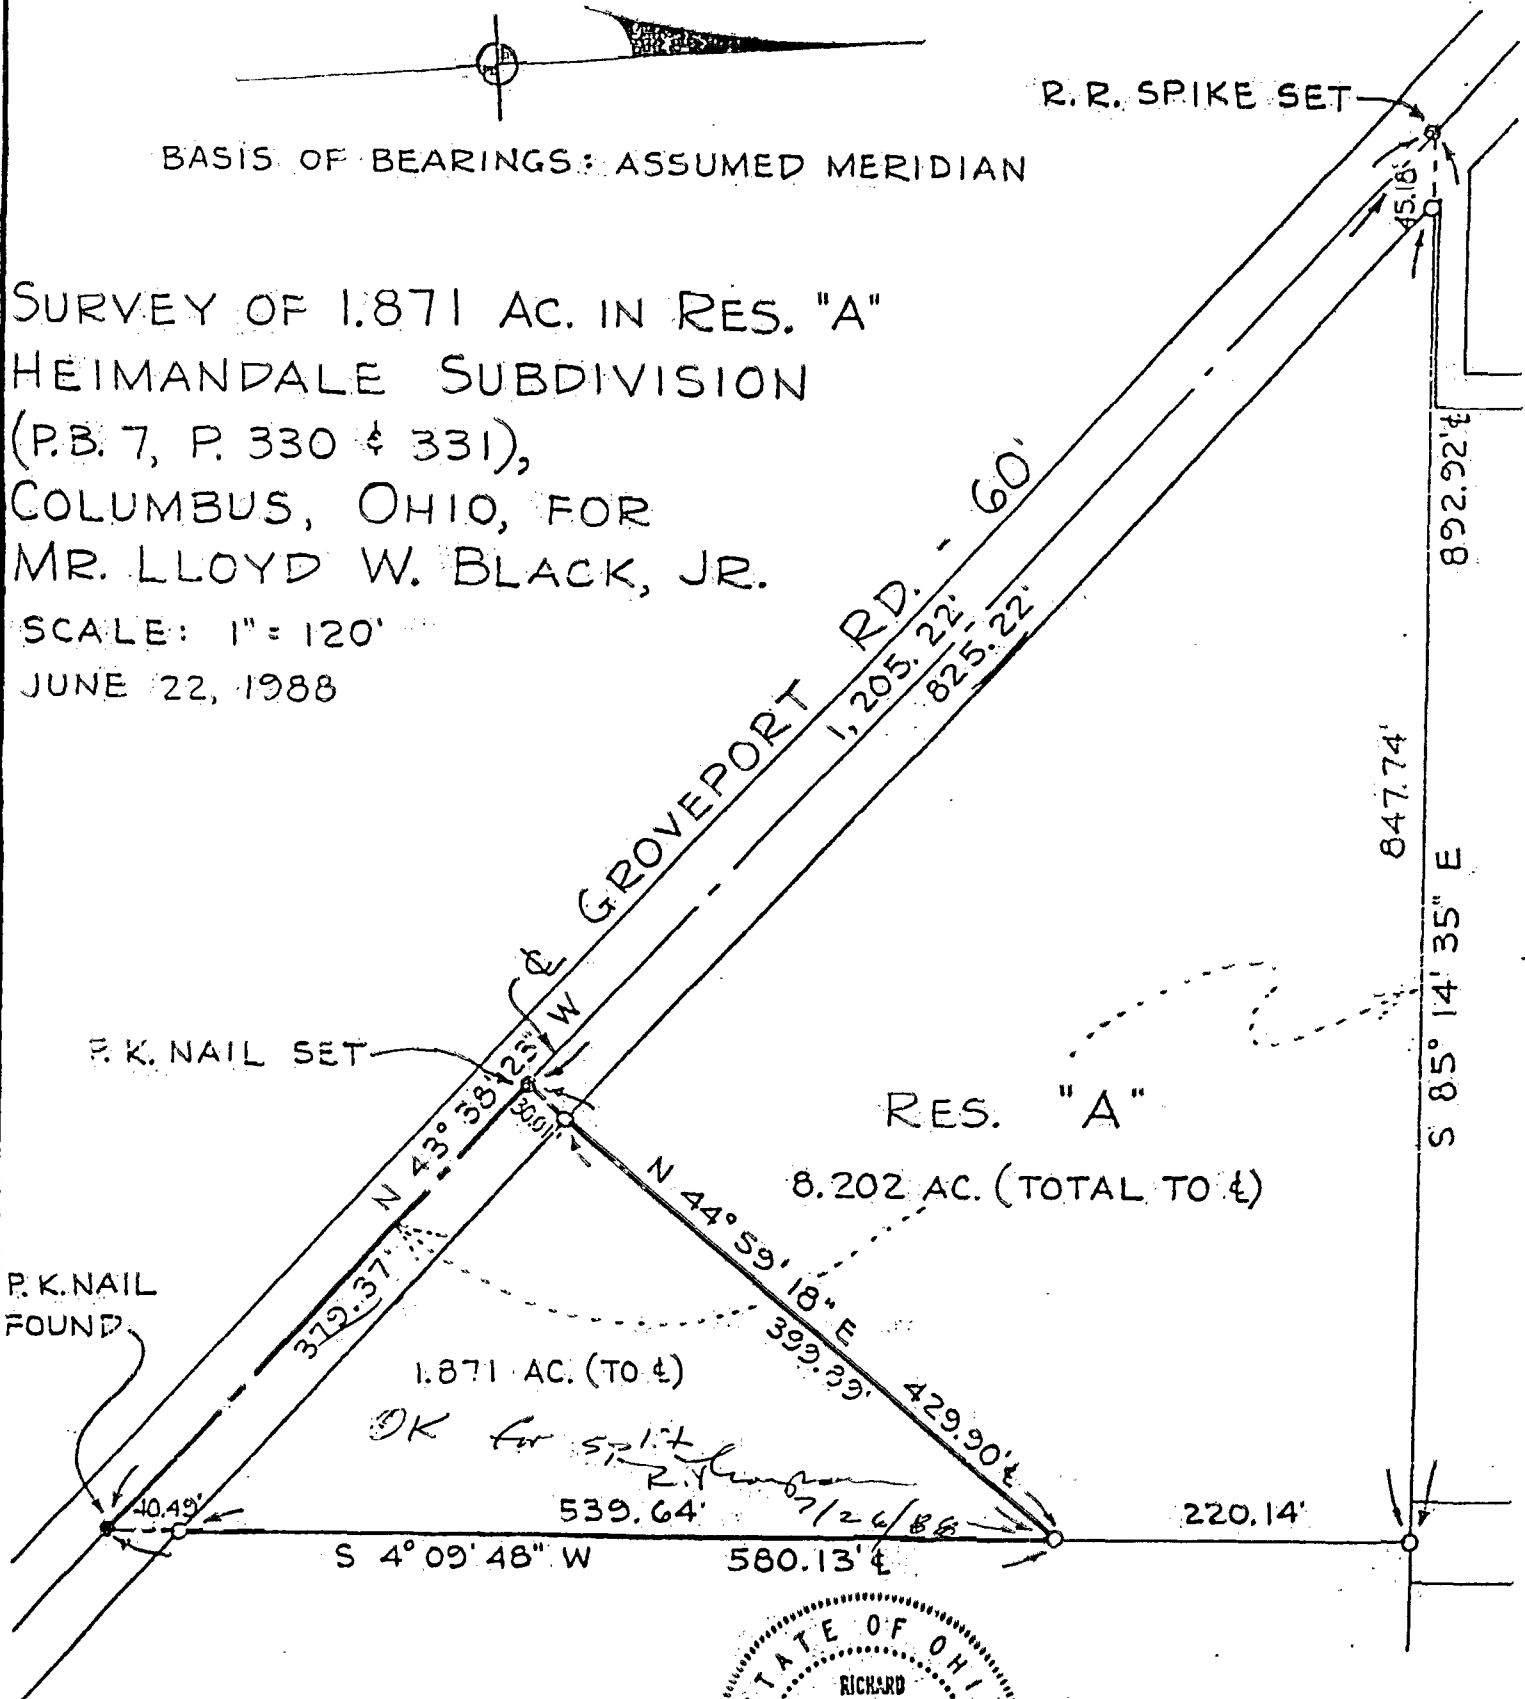

R. R. SPIKE SET


P. K. NAIL SET

RES. "A"

8.202 AC. (TOTAL TO £)

1.871 AC. (TO £)

*OK for split
R. J. Bull
7/26/88*

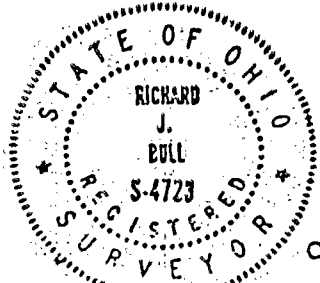

C. F. BIRD & R. J. BULL, INC.
2875 W. DUBLIN-GRANVILLE RD.
WORTHINGTON, OHIO

Richard J. Bull

#4723

86-144

0 - 3/4" I.D. IRON PIPE SET