

Myers Surveying Company, Inc.

2740 East Main Street, Columbus 43209 (Bexley), Ohio
 614-235-8677 FAX: 614-235-4559

8335-2495
93606975

A Mortgage Location Survey prepared for and certified to:
Yerke Mortgage Company


Legal Description: 0.254 Acres, Lot 4, Sect. 3, Township 4, Range 22, Parcels 13, 14, 15, M.J. McDowell's Lawndale Avenue Block of Lots (aka Greenhill Acres) unrecorded

Applicant: Klotz

Posted Address: 818 Lawndale Avenue, Columbus, Ohio

F.E.M.A. Flood Zone Designation: Flood Zone "C" as per F.I.R.M. 390170 0090B.

Apparent Encroachments: 1) Overhead Wires Crossing Property. 2) High Pressure Gas Line Crossing Property.

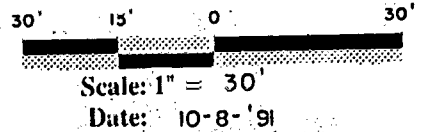


SURVEY RECEIPT (We hereby certify that I/we have examined the survey for the property that I/we have just purchased, and I/we hereby acknowledge receipt of a copy of such survey.)


Richard L. Klotz
Rita A. Klotz



0-34-AA

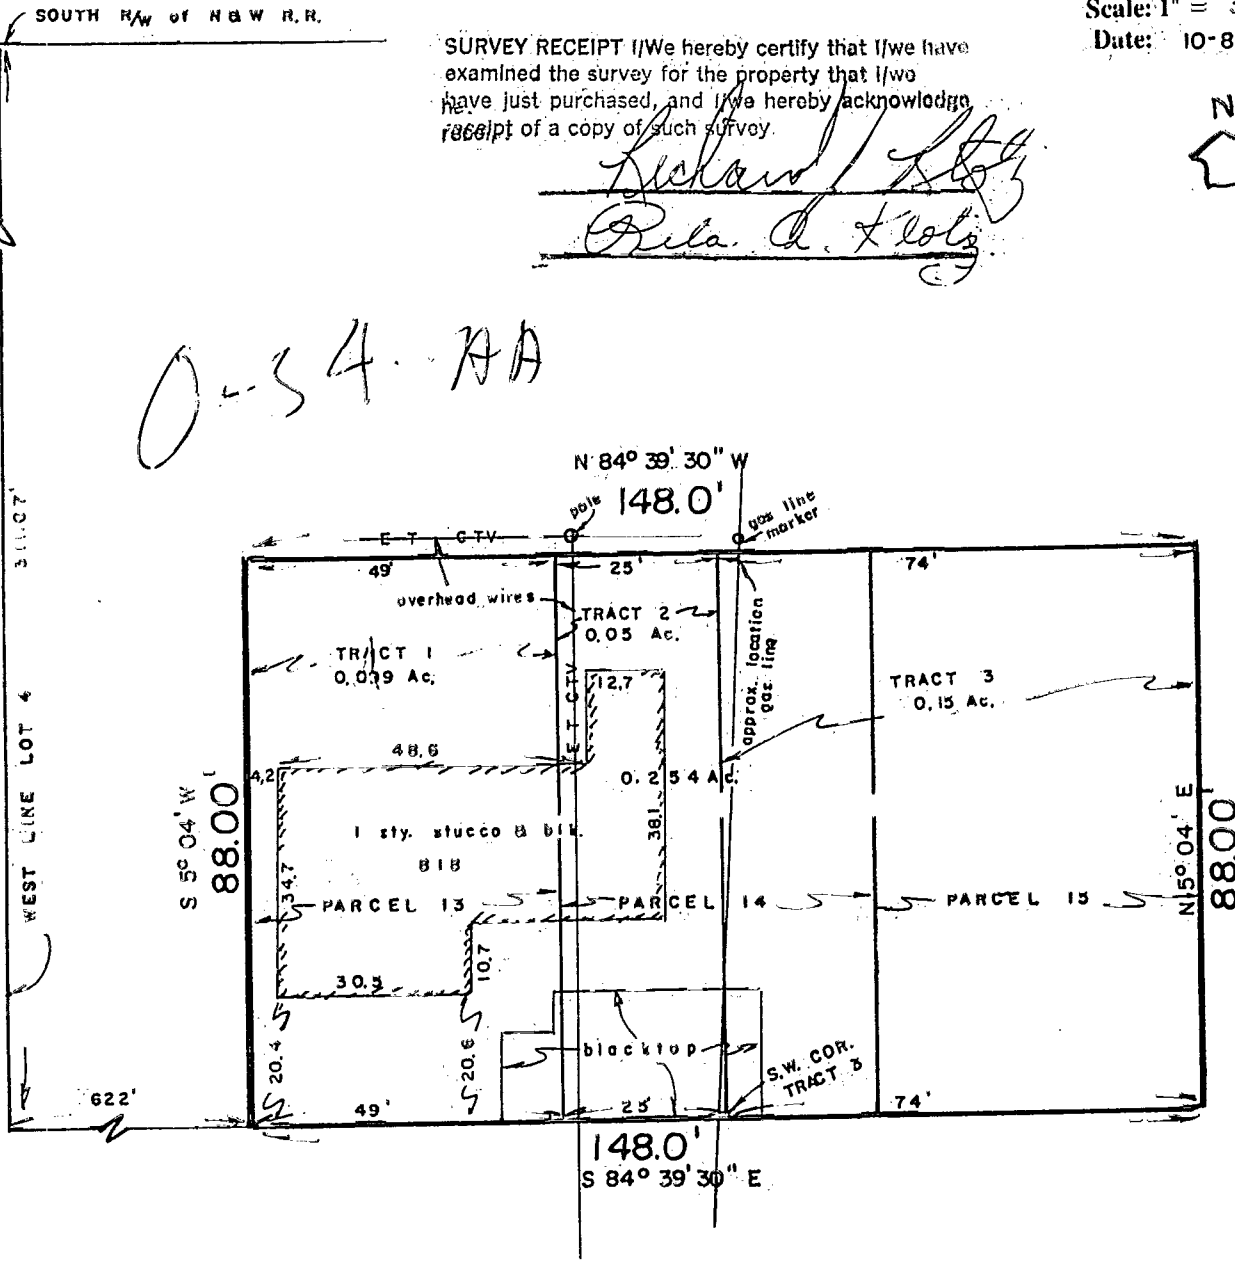

LAWNDALE AVE. 50'
 (Dedicated P.B. 20, PG. 22)

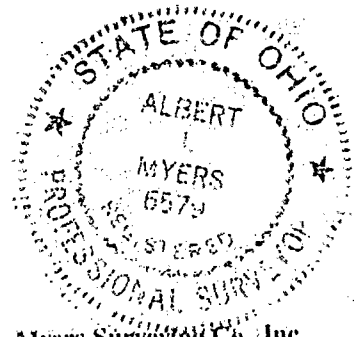

Myers Surveying Co., Inc.
 By *Albert Myers*
 Professional Surveyor

We hereby certify that the foregoing Mortgage Location survey was prepared from actual field measurements in accordance with Chapter 4733-38 Ohio Administrative Code, and is not a boundary survey pursuant to Chapter 4733-37 of said code.
THE INFORMATION SHOWN HEREON IS NOT TO BE UTILIZED FOR THE INSTALLATION OF BUILDINGS, FENCES, LANDSCAPING OR OTHER PERMANENT IMPROVEMENTS.