


Pomeroy & Associates Ltd.

Consulting Engineers & Surveyors

599 Scherers Court • Worthington, Ohio 43085
Phone (614) 885-2498 • Fax (614) 885-2886

3.174 & 2.752 ACRE TRACTS
LOT SPLITS
1651 REFUGEE ROAD
COLUMBUS, OHIO

83856975

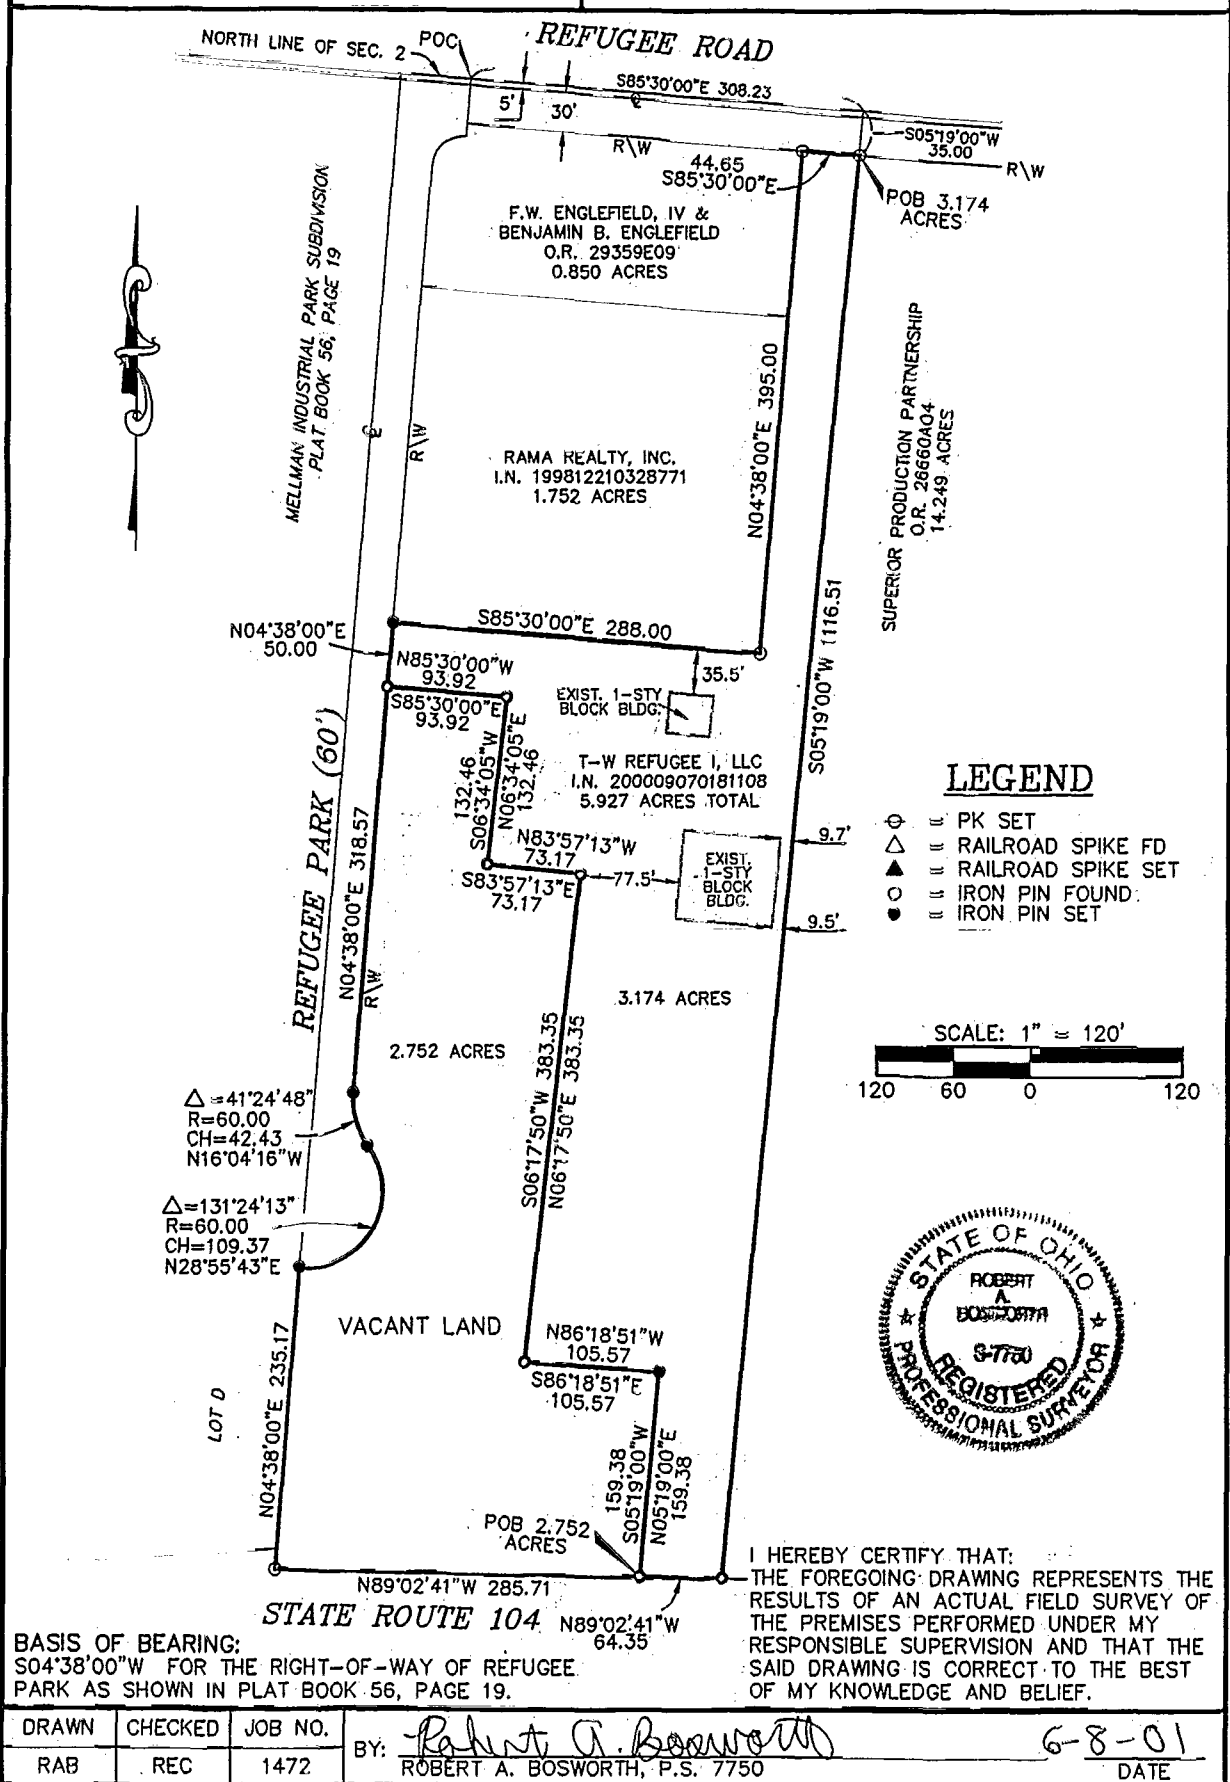

BASIS OF BEARING:
S04°38'00"W FOR THE RIGHT-OF-WAY OF REFUGEE PARK AS SHOWN IN PLAT BOOK 56, PAGE 19.

| | | | | |
|-------|---------|---------|-------------------------------|--------|
| DRAWN | CHECKED | JOB NO. | BY: <i>Robert A. Bosworth</i> | 6-8-01 |
| RAB | REC | 1472 | ROBERT A. BOSWORTH, P.S. 7750 | DATE |

WALTON TRUP
0-54-B