



84356925

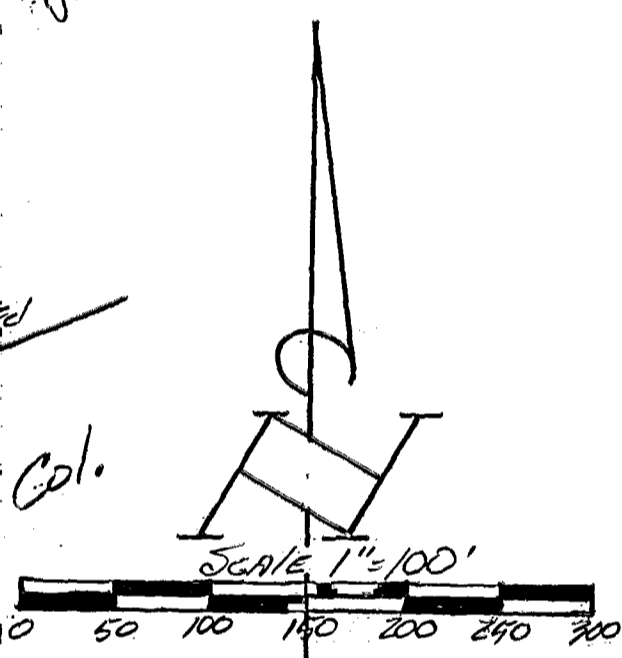

Basis of BEARINGS:  
 Old Refugee Road as  
 N89°22'20"E. FROM  
 D.Plot Plan - FRA-104-1057

SURVEY OF 1.210 ACRES  
 in the NW 1/4 Sec. 1, Twp. 4, Rge. 22,  
 City of Columbus, Franklin Co.,  
 Ohio: FOR  
PARKER DUNIGAN

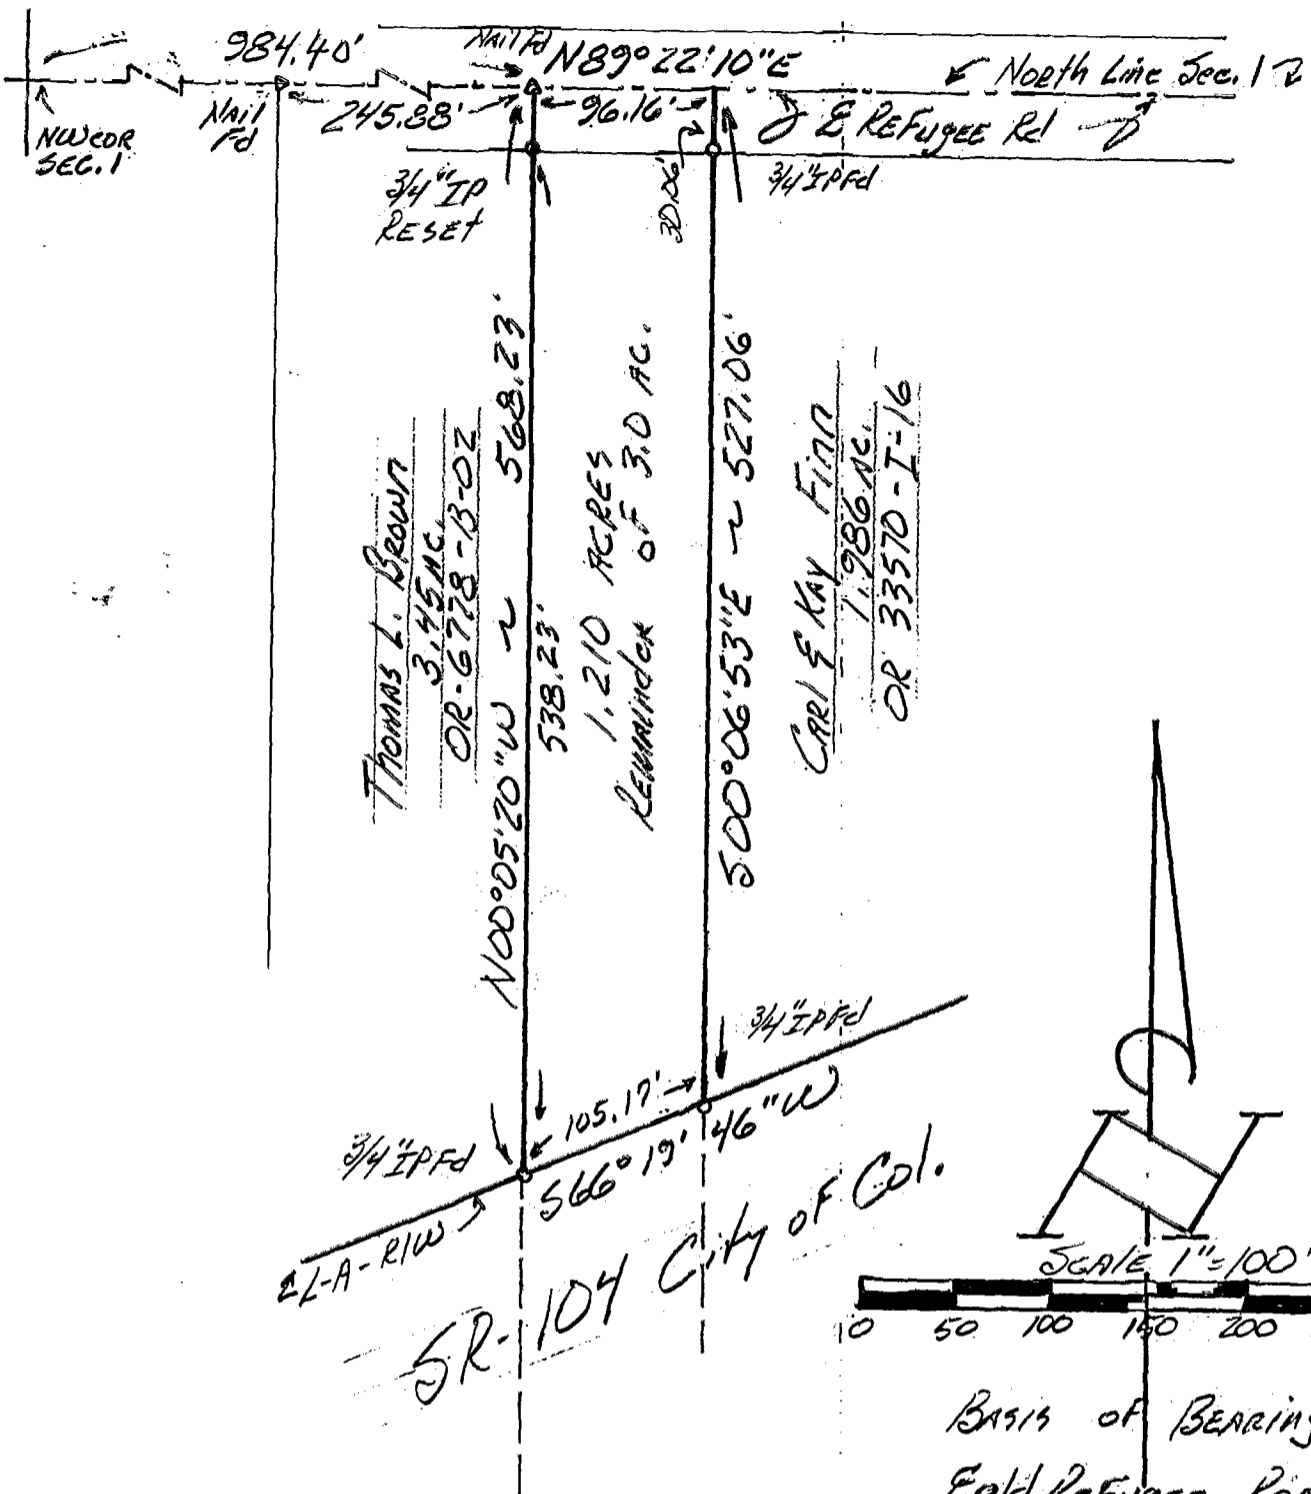

**HAINES SURVEYORS**  
 354 Kessler Street  
 Groveport, Ohio 43125  
 Phone: 837-2181

I hereby certify that the plat shown hereon was performed from an actual field survey, under my supervision and that said plat correctly represents said survey.  
 DATE Sept. 16, 1997 SIGNED Louis F. Haines

D-54-C  
 MARION Twp.