


Arnold Survey Company

3911 BROADWAY STREET · SUITE C · GROVE CITY, OHIO 43123 · TEL. (614)875-7684

BOUNDARY / LOT SPLIT

BASIS OF BEARING IS THE CENTERLINE OF FIRST AVENUE BEING DUE EAST AS OBTAINED FROM ACTUAL FIELD MEASUREMENTS ON 6-27-96

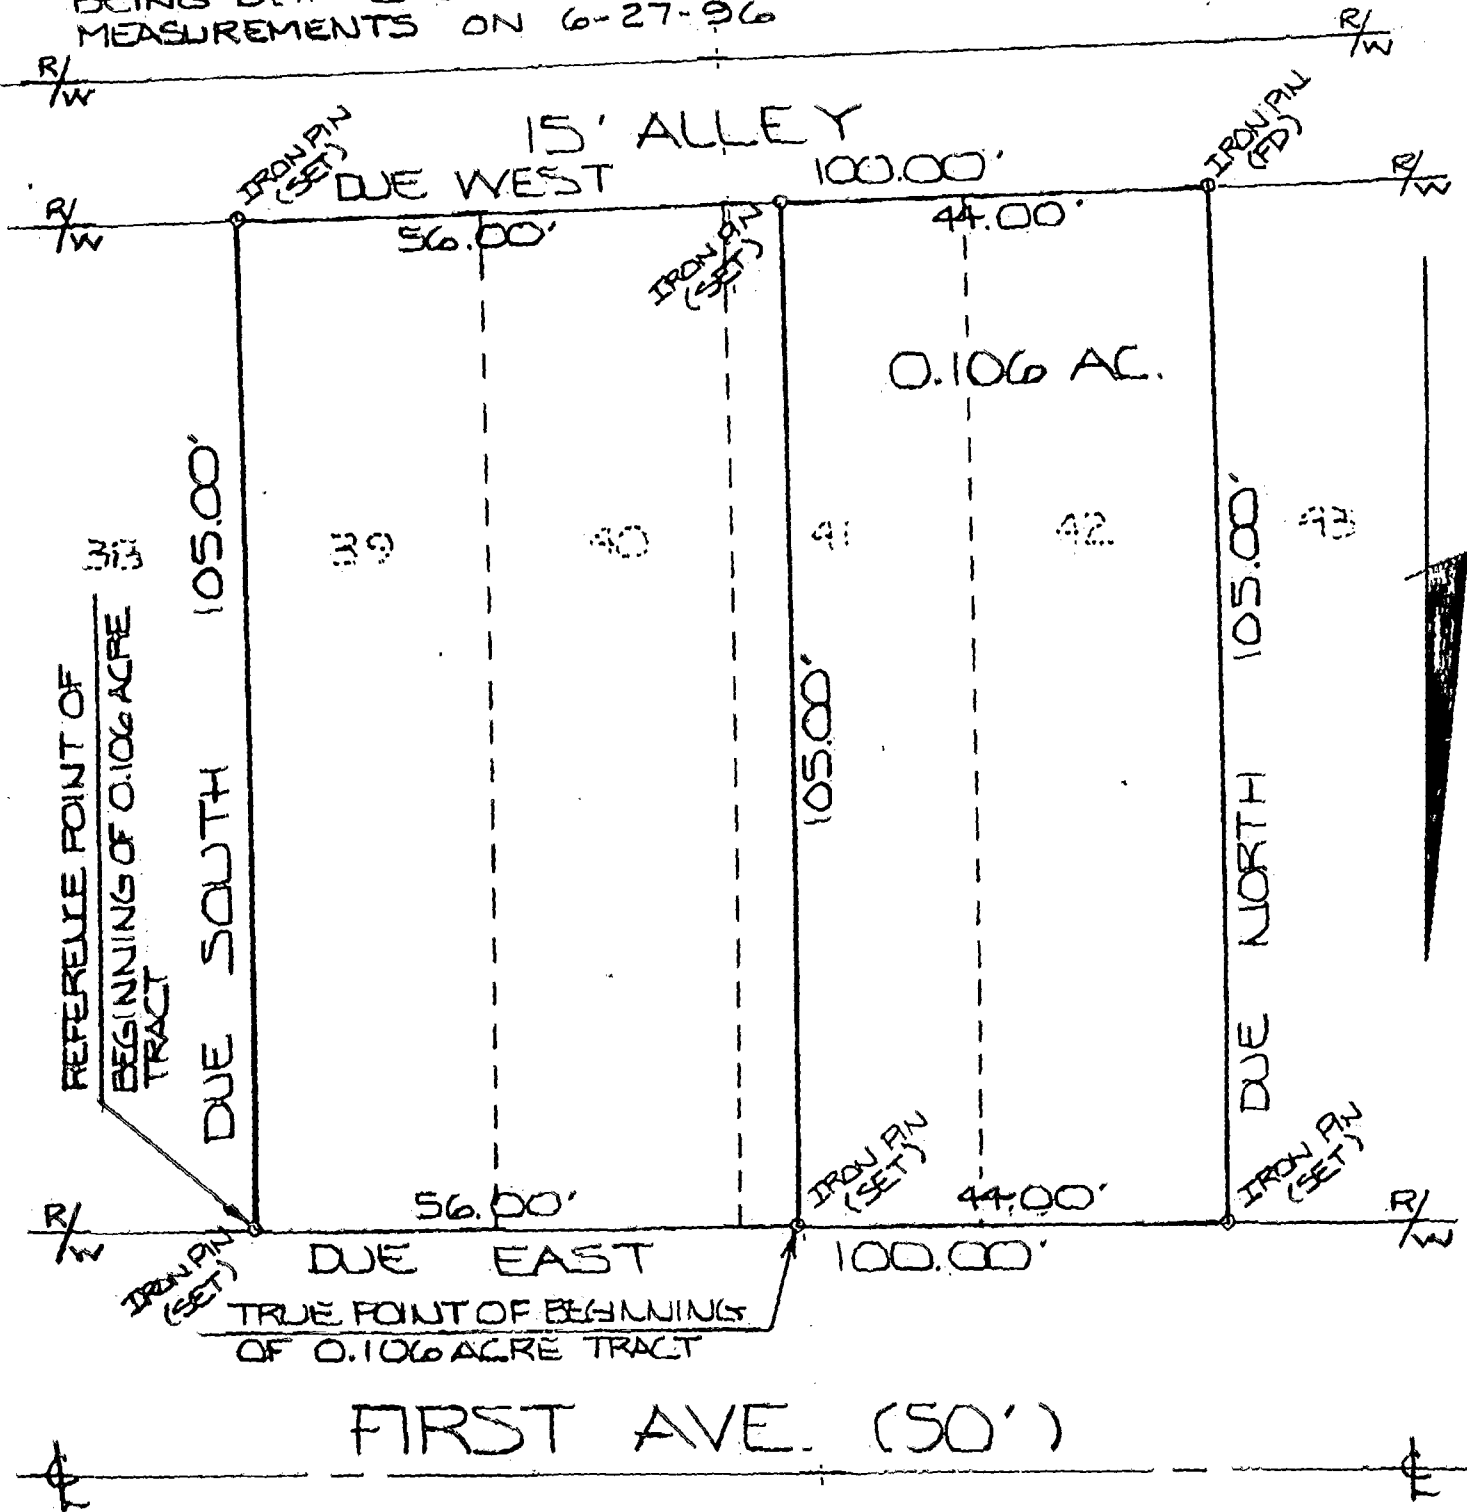

URBANCREST SUBDIVISION
PLAT BOOK 4, PAGE 3
FRANKLIN CO., OHIO



I HEREBY CERTIFY THAT THE ATTACHED PLAT WAS PREPARED FROM INFORMATION OBTAINED FROM AN ACTUAL FIELD SURVEY OF THE PREMISES AND THAT SAID PLAT IS CORRECT TO THE BEST OF MY KNOWLEDGE.

Roger P. Arnold
 REGISTERED SURVEYOR NO. 8085
 ROGER P. ARNOLD

6-28-96
FILE: C44-1
SCALE: 1" = 20'

JACKSON 180 356 900