M-86-A

Servey Book # 1
Page 111

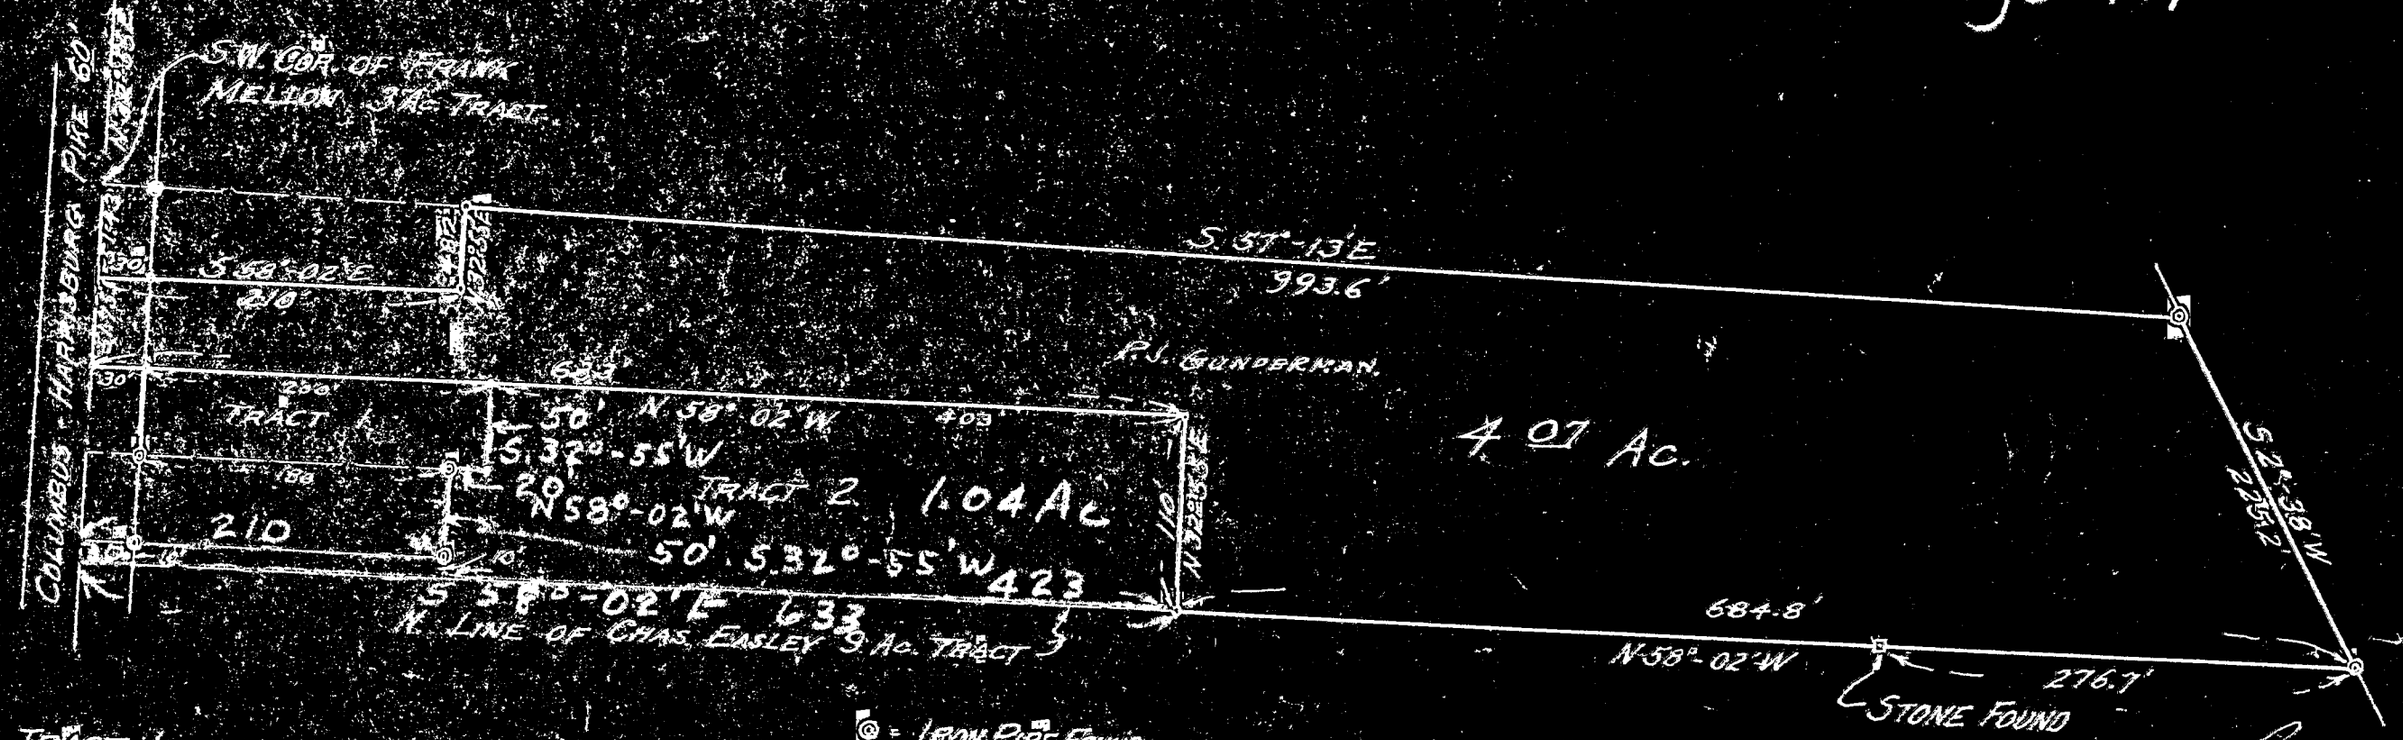

TRACT 1
DEED BOOK 602, P. 519 EMANUEL A. WHITE AND MARY, HIS WIFE - TO FRANK O. HORTON - OCT. 3, 1917 CONVEYED TO SHOVER FEB. 14, 1919.

TRACT 2.
DEED BOOK 627, P. 189 - EMANUEL A. WHITE AND MARY, HIS WIFE - TO CHAS. EASLEY - FEB. 5, 1919. DESCRIPTION CALLS FOR N.E. COR. OF F.O. HORTON'S LOT AS PLACE OF BEGINNING.

⊙ = IRON PIPE FOUND
■ = IRON PIPE SET

SURVEY BY: [illegible]

PLAT OF 4.07 Ac.
FOR
P.J. GUNDERMAN
AND 1.04 Ac FOR GLENN AND FLOSSIE LOTZ
BEING A PART OF SURVEY No. 1388, VIRGINIA MILITARY LANDS, - JACKSON TWP., FRANKLIN CO., O.
JUNE 10, 1939
SCALE 1" = 100'

40 W. GAY ST.
PHONE AD. 9656