


SW line LOTS DRIVE - RESERVE "A"  
 GROVE CITY ADDITION  
 GLENN L. LOTZ

NORTH BROADWAY

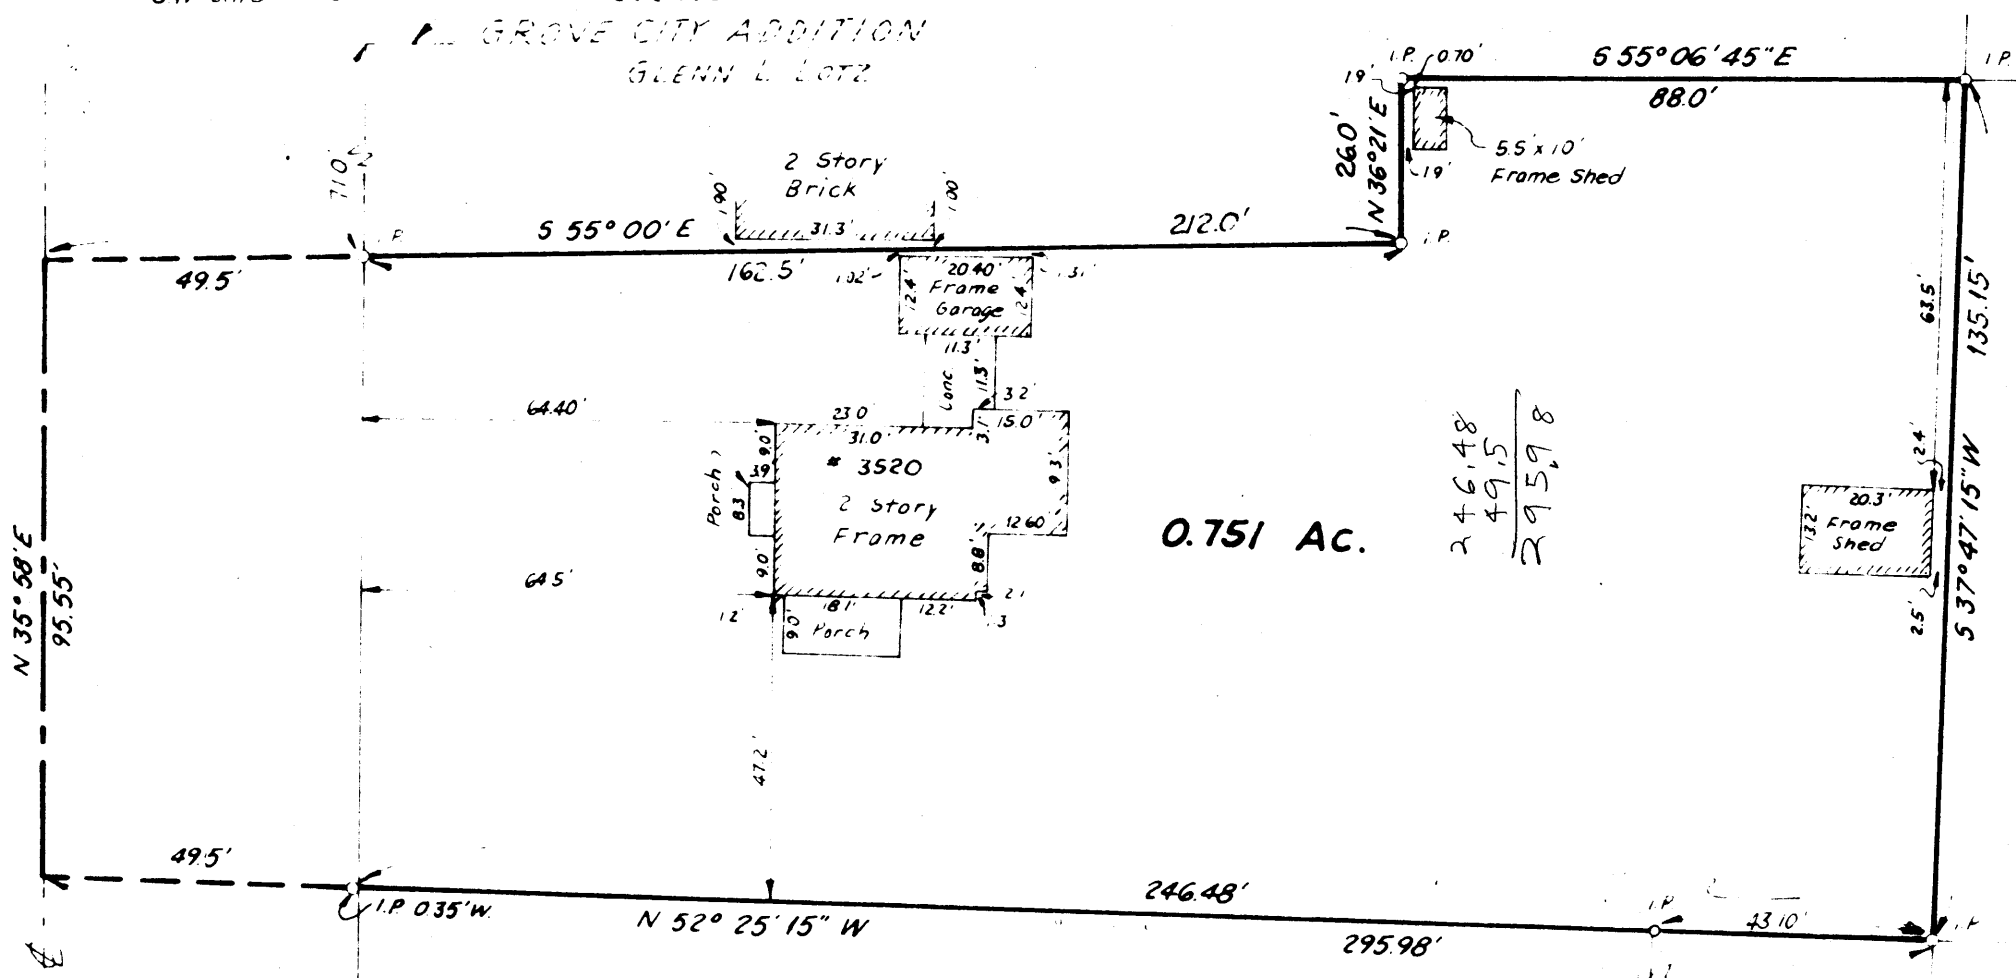

0.751 Ac.

246.48  
 49.5  
 295.98

EVA & ORVILLE A. KOEHLER  
 DB 2247 Pg 488

DB 2060  
 Pg 639

0.751 ACRE TRACT  
 PART OF SURVEY 1388 V.M.L.  
 GROVE CITY  
 FRANKLIN CO., OHIO  
 for  
**B. J. ROACH**

SCALE 1" = 30' MAY, 1967

Survey BK 2 Pg 135

THE JENNINGS LAWRENCE CO.  
 Civil Engineers and Surveyors  
 150 S. Bailey Avenue  
 Columbus, Ohio

By: Roy T. Underwood  
 Registered Surveyor

ROBERT M. & EDITH SALTS  
 DB 2357 Pg 359

①-31  
~~A-86 A~~  
 M-89  
 180106850