
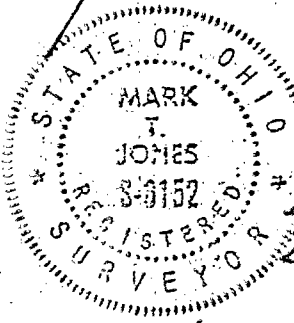


(7 31 1)

JACKSON TRIP
 C-31-D

030
 0314
 1976
 0314
 042
 071
 120
 2000

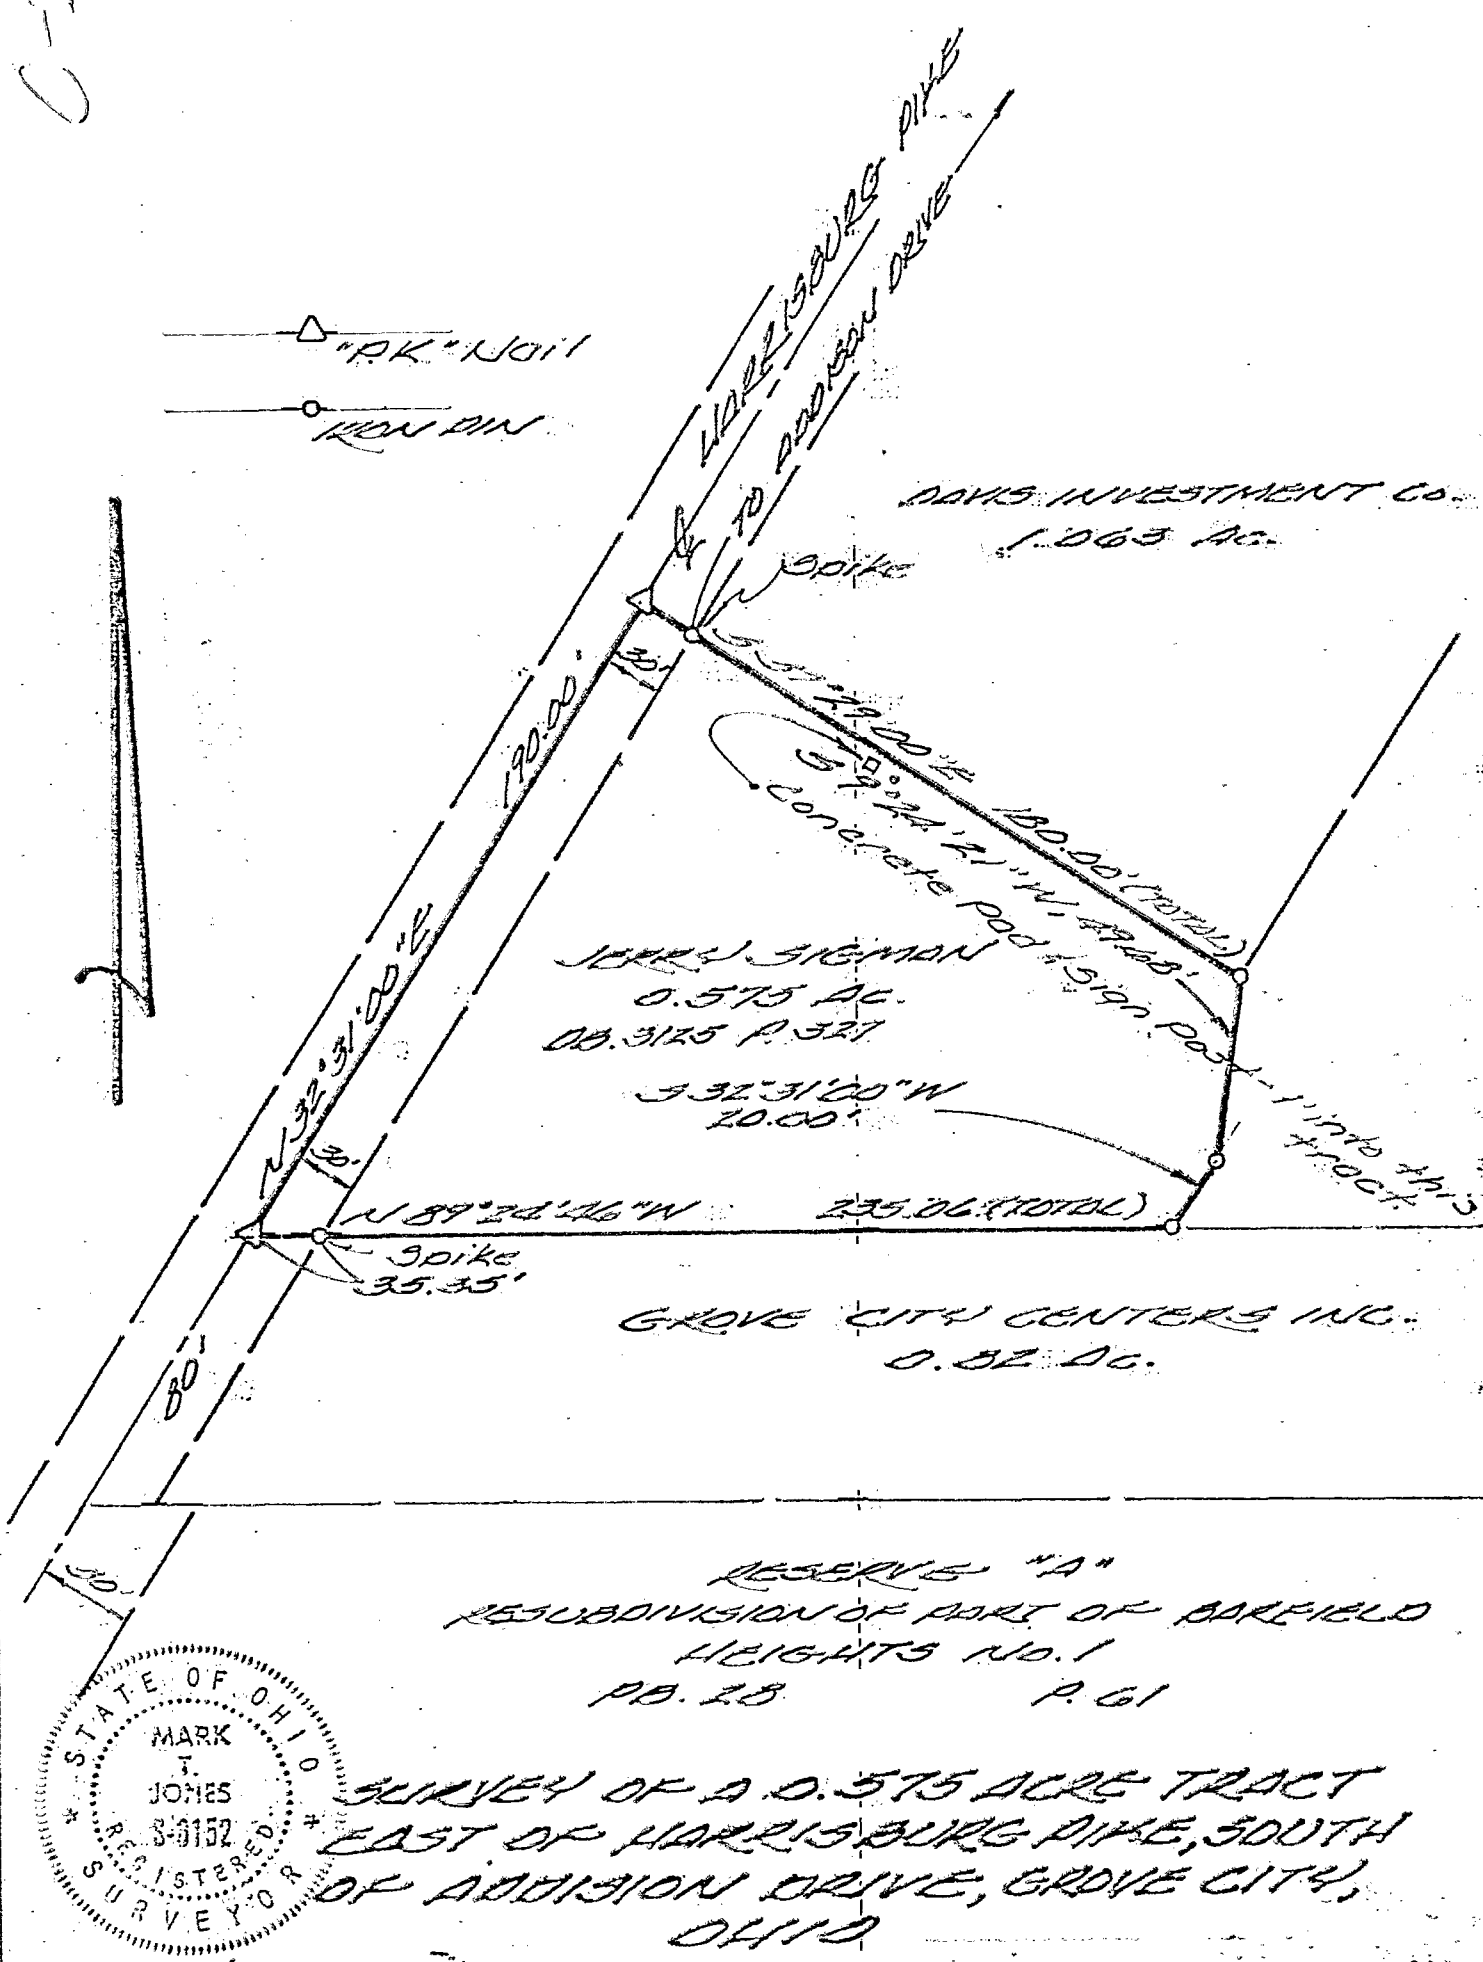

RESERVE "A"
 RESUBDIVISION OF PART OF BARKFIELD
 HEIGHTS NO. 1
 PB. 28 P. 61

**SURVEY OF A 0.575 ACRE TRACT
 EAST OF HARRISBURG PIKE, SOUTH
 OF ADDITION DRIVE, GROVE CITY,
 OHIO**

We hereby certify that the foregoing plat was prepared from an actual survey of the premises.

SCALE 1" = 50'

DATE: 9-15-76 3340A HOCKADEN AND ASSOCIATES, INC.

REVISED DATE: ORDER NUMBERS

By: *Mark T. Jones*
 Registered Surveyor

SURV'D.	DRAWN	CHECKED
H. R.	J. W.	M. T.

528 956 875