



**BROOKPARK
SUBDIVISION**
PLAT BOOK 36, PAGE 72
FRANKLIN CO. OHIO

M 84-B

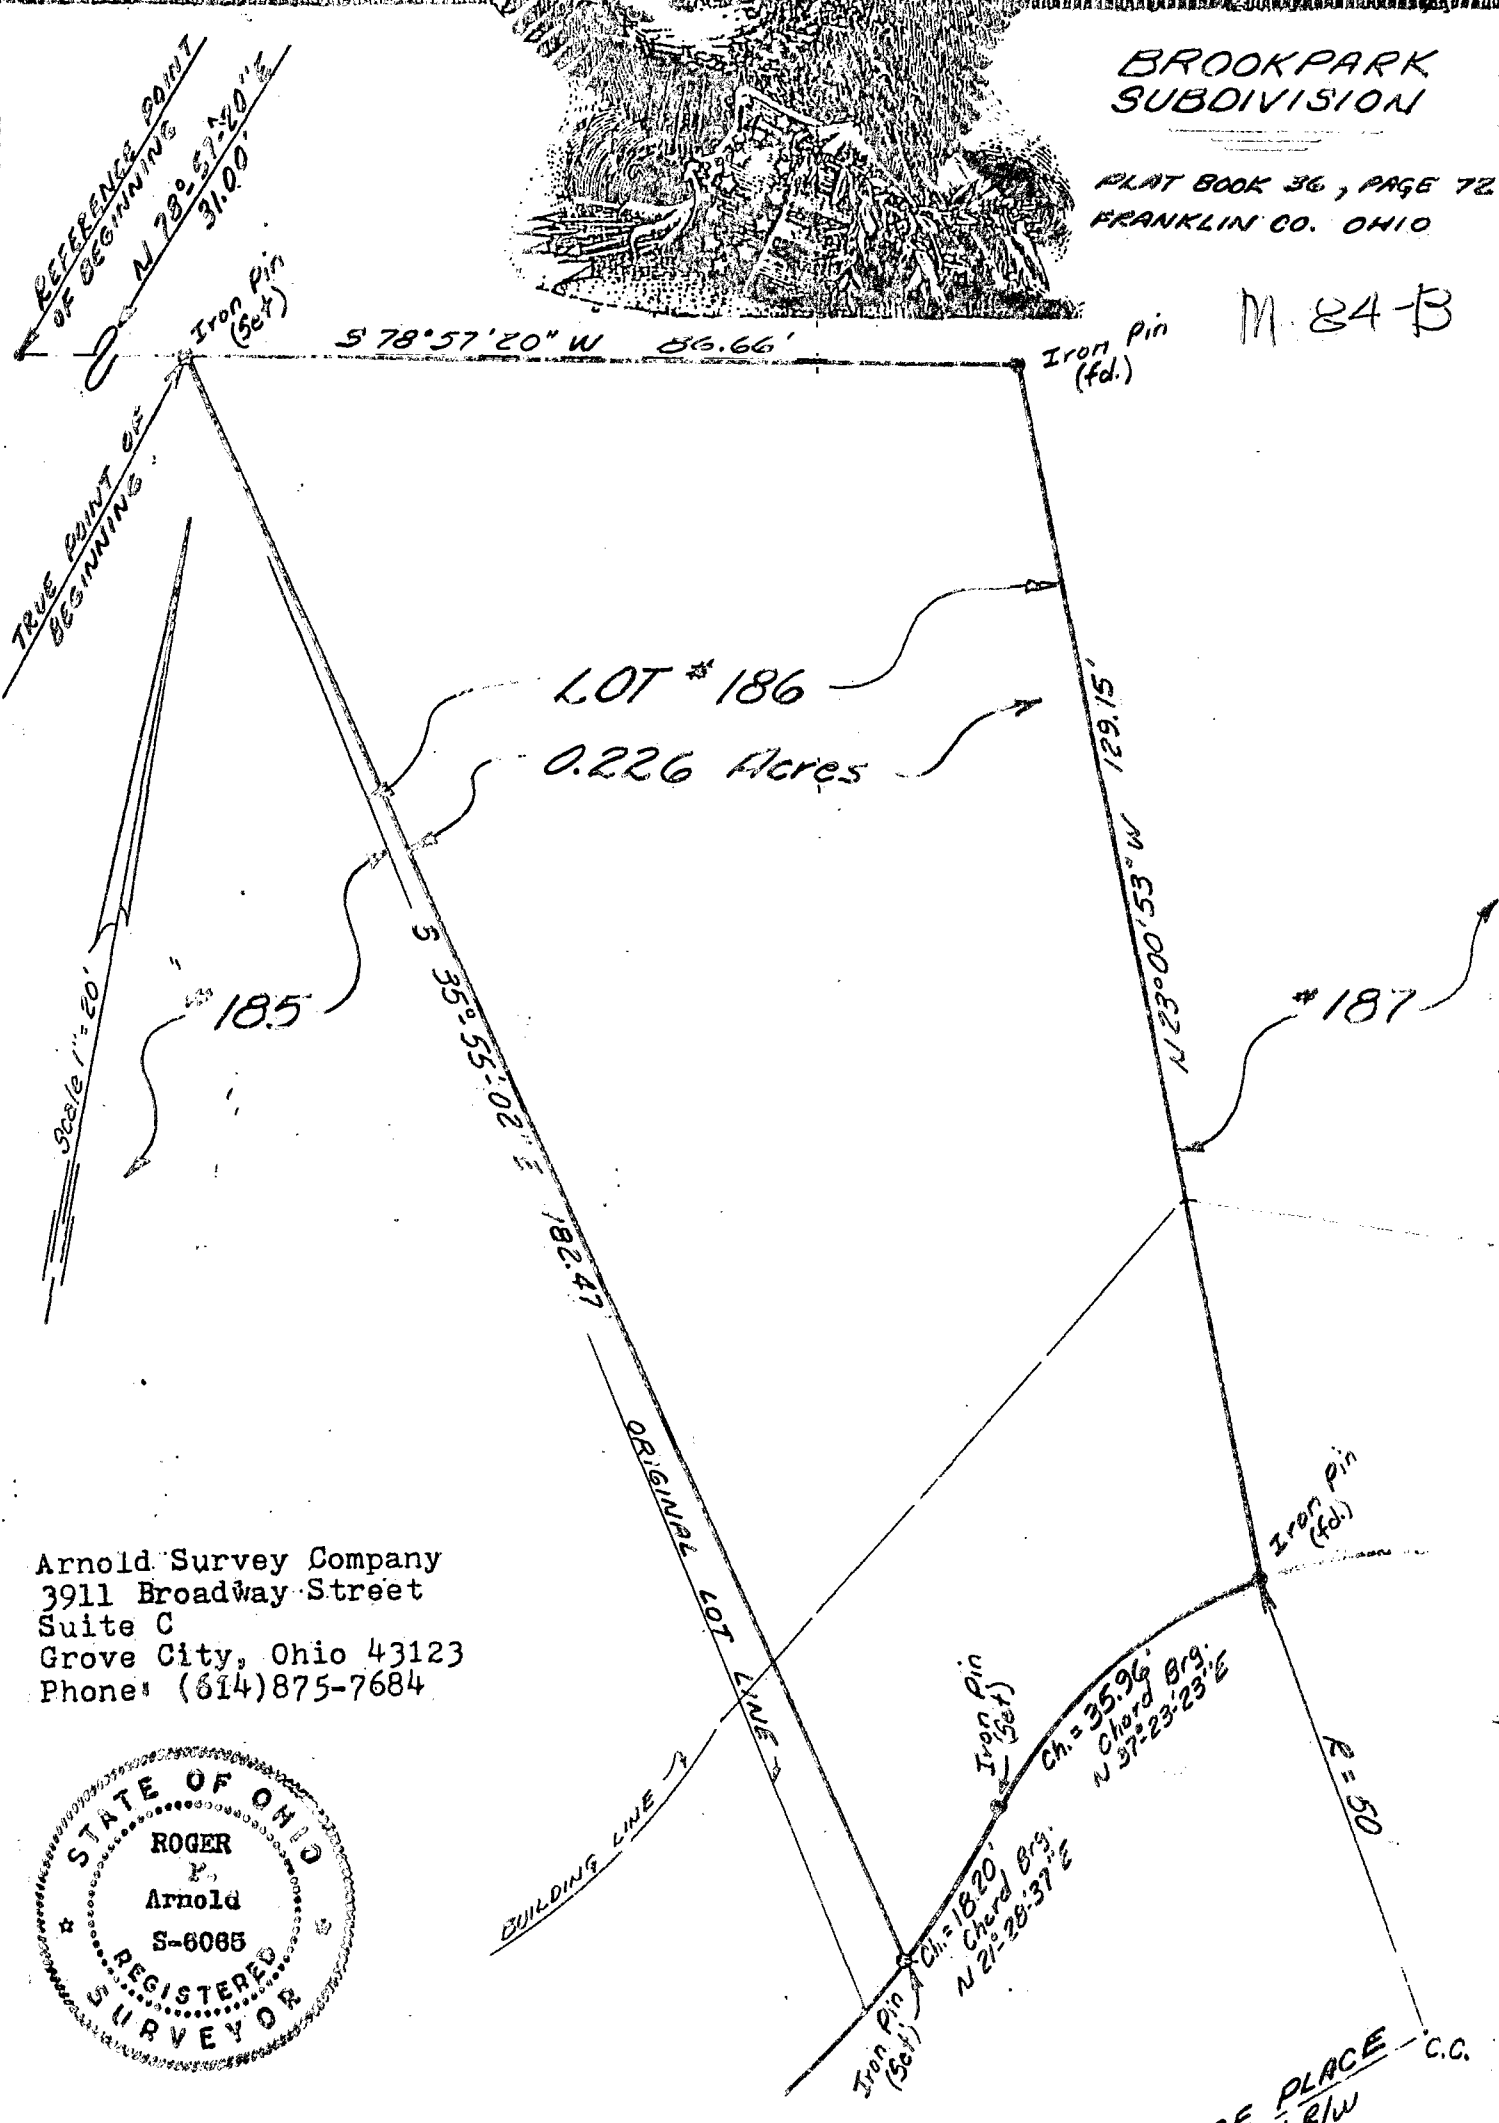

Arnold Survey Company
3911 Broadway Street
Suite C
Grove City, Ohio 43123
Phone: (614) 875-7684

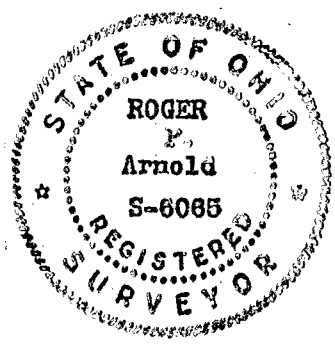

I hereby certify that the attached plat was prepared from information obtained from an actual field survey of the premises, and that said plat is correct.

Roger P. Arnold
Registered Surveyor # 6085 Date Nov. 12, 1986

LOUISE PLACE
50' R/W C.C.