

JERRY A. MALOTT SURVEYING Co.



6810 East Main Street ~ Suite 101, Columbus, Ohio 43068 (614) 577-0957

FOR: 180856850

B. J. ROACH BOUNDARY SURVEY

STRING.DWG

M-86-FF

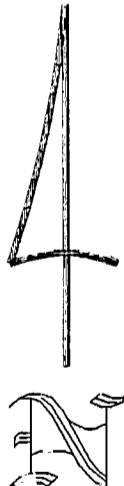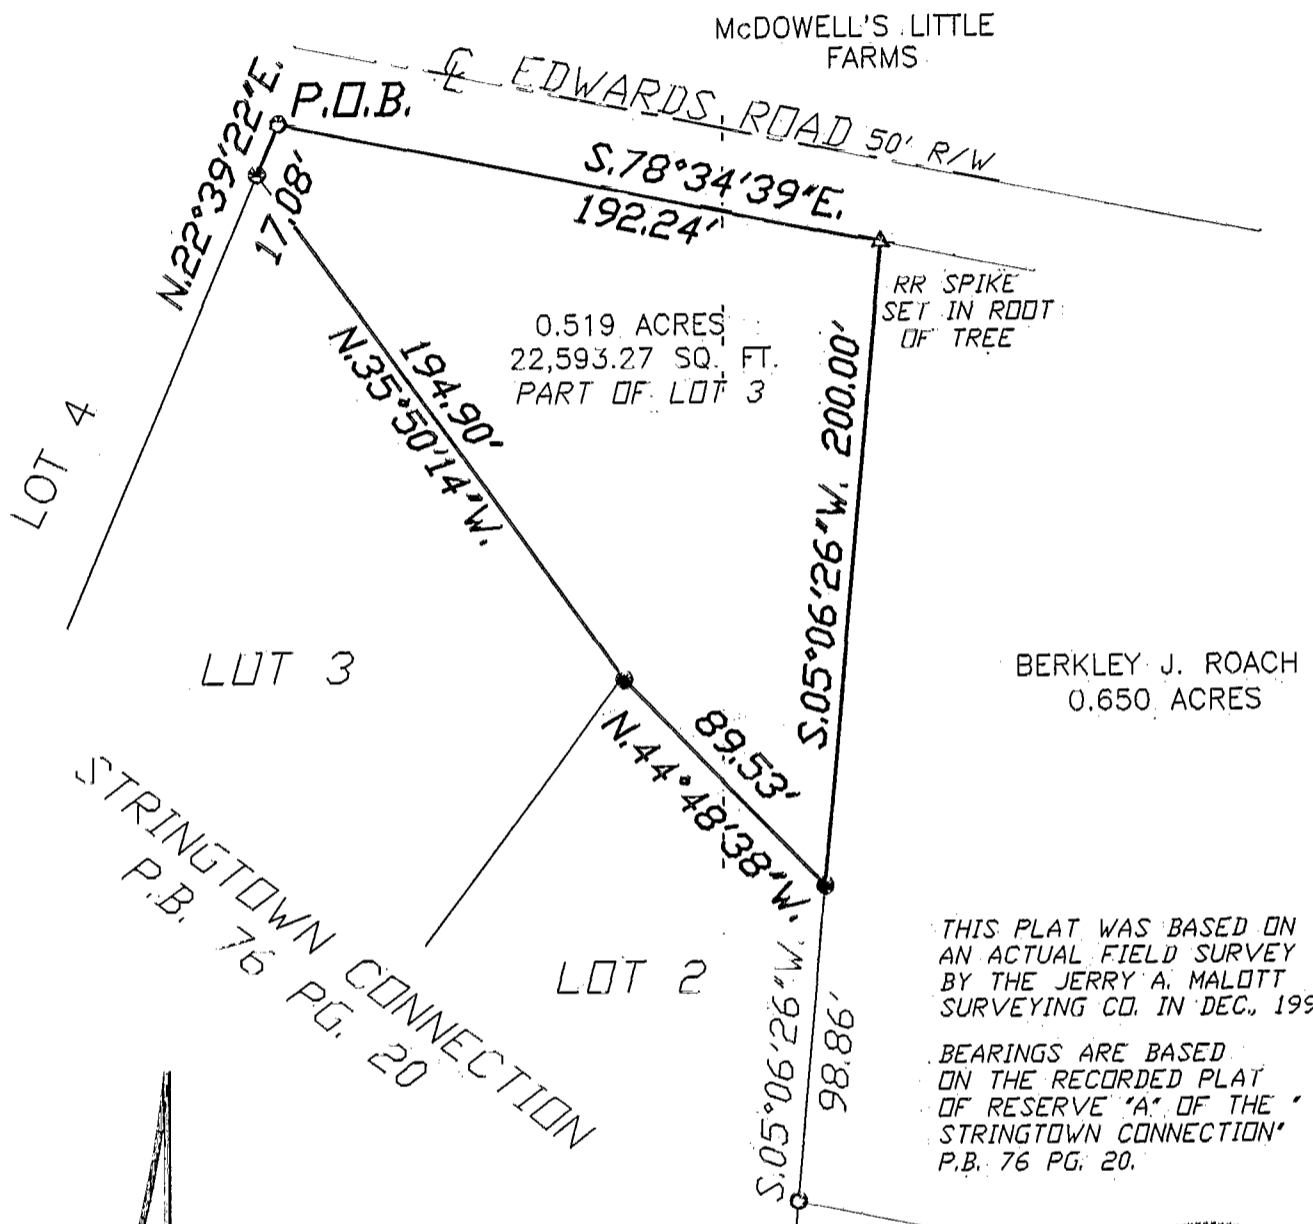


LEGEND

- IRON PIN SET
- ▲ RAILROAD SPIKE SET



GRAPHIC SCALE

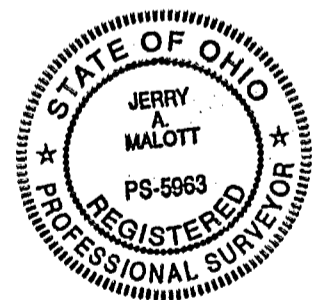

BY *Jerry A. Malott*
Professional Surveyor
JERRY A. MALOTT

SCALE 1"=60' DATE 12/21/94

LOCATION STATE OF OHIO, COUNTY OF FRANKLIN, JACKSON TOWNSHIP
CITY OF GROVE CITY, AND BEING A PART OF LOT 3 OF STRINGTOWN
CONNECTION SUBD. AS RECORDED IN PLAT BOOK 76, PAGE 20.

M-86-FF