

80856850

0-32-F
JACKSON TWP.

PLAT OF SURVEY


FRANKLIN COUNTY, OHIO
JACKSON TOWNSHIP, GROVE CITY
VIRGINIA MILITARY SURVEY NO. 8231

BASIS OF BEARINGS



Bearings shown hereon were taken from previous surveys prepared for Sonora Drive Apartments, The State of Ohio tract and The City of Grove City tract.

DEED REFERENCES

OWNER	RECORDING NUMBER
The Grove City Development Co.	Vol. 3109, Pg. 285
SONORA DRIVE Dedication	P.B. 46, Pg. 33
The City of Grove City	O.R. 393 I II
Stringtown Road Associates	Vol. 3796, Pg. 761
State of Ohio	Vol. 3485, Pg. 437
SONORA DRIVE Apartments Inc.	O.R. 8580 I O2

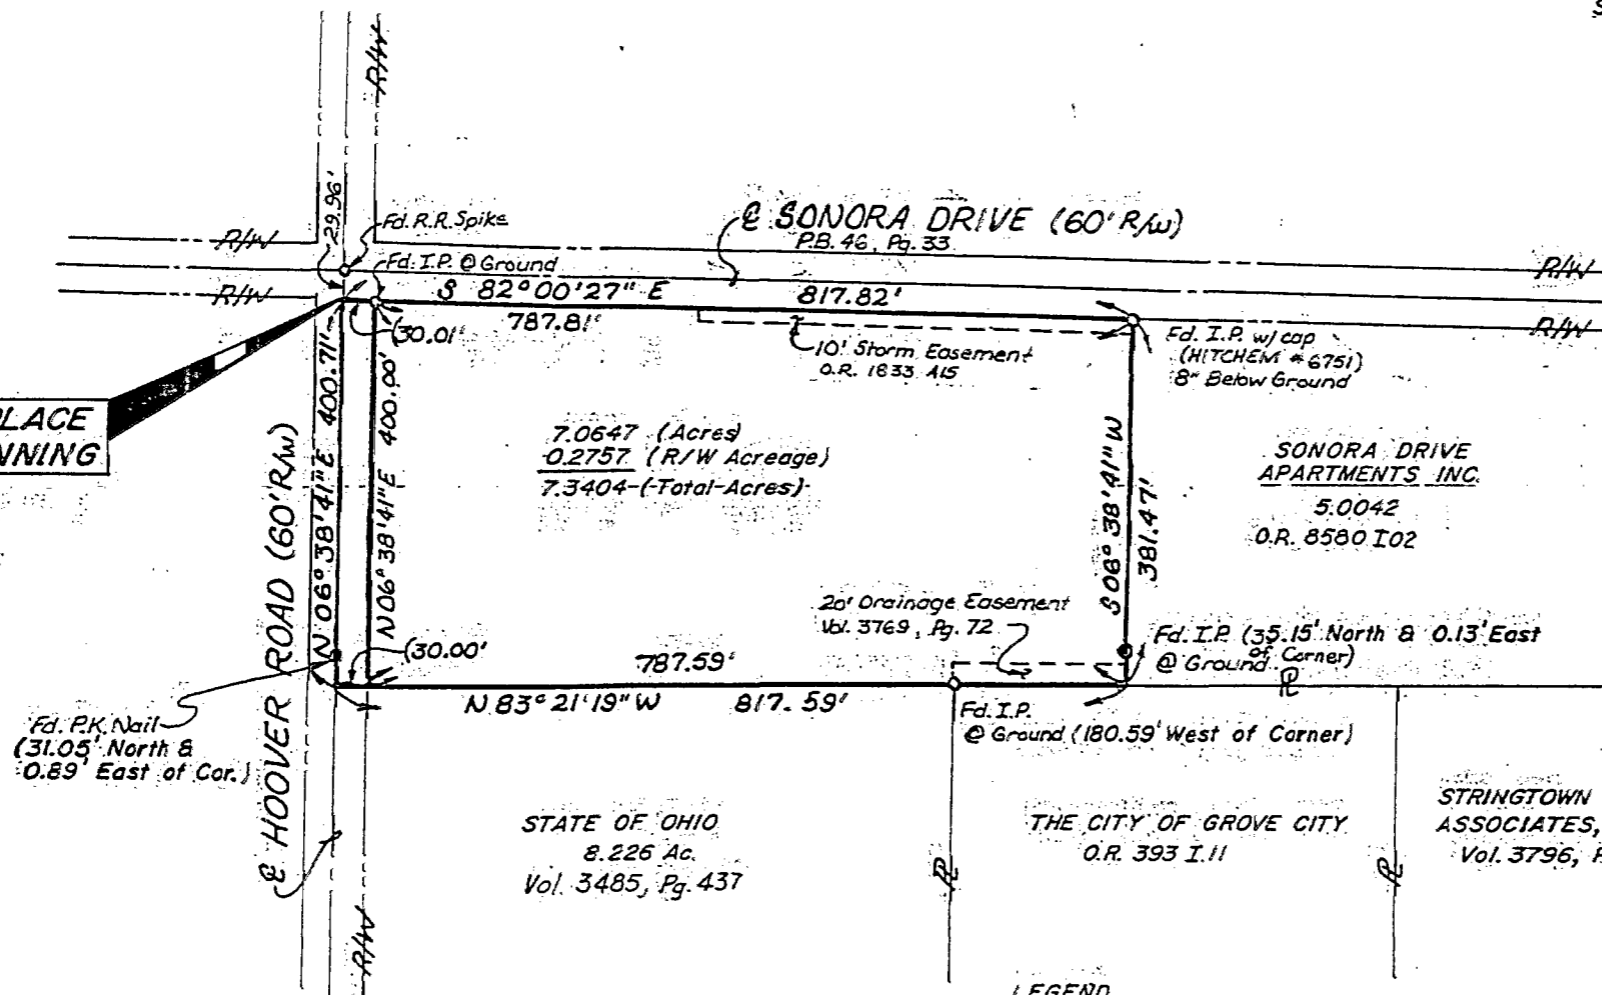

TRUE PLACE OF BEGINNING

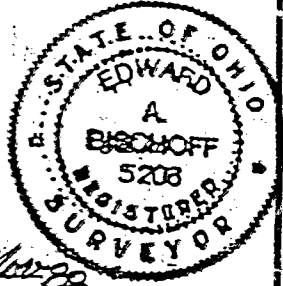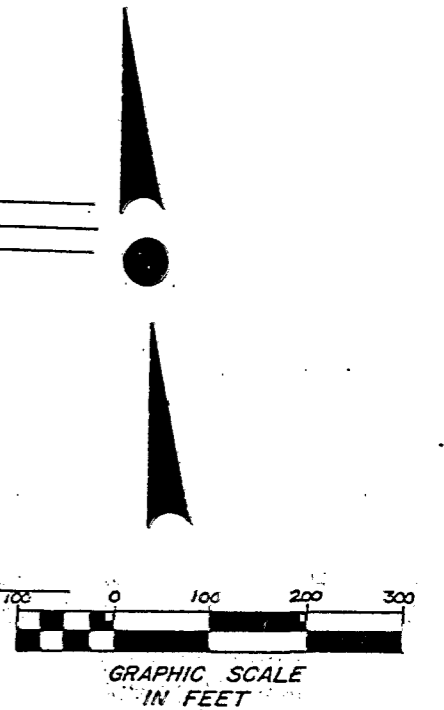

Edward A. Bischoff
Registered Surveyor No. 5206
DATE 12/11/28

- LEGEND
- - Monument (Found)
 - - Monument (Set)

BISCHOFF & ASSOCIATES, INC.
3428 BRINT AVENUE
GROVE CITY, OHIO 43123
Consulting Engineers
ESTD BY BISHOP & ASSOCIATES, INC.
1928