HOCKADEN-LIPES-ROUSCULP, INC.
CONSULTING ENGINEERS
883 N. CASSADY AVENUE
COLUMBUS, OHIO

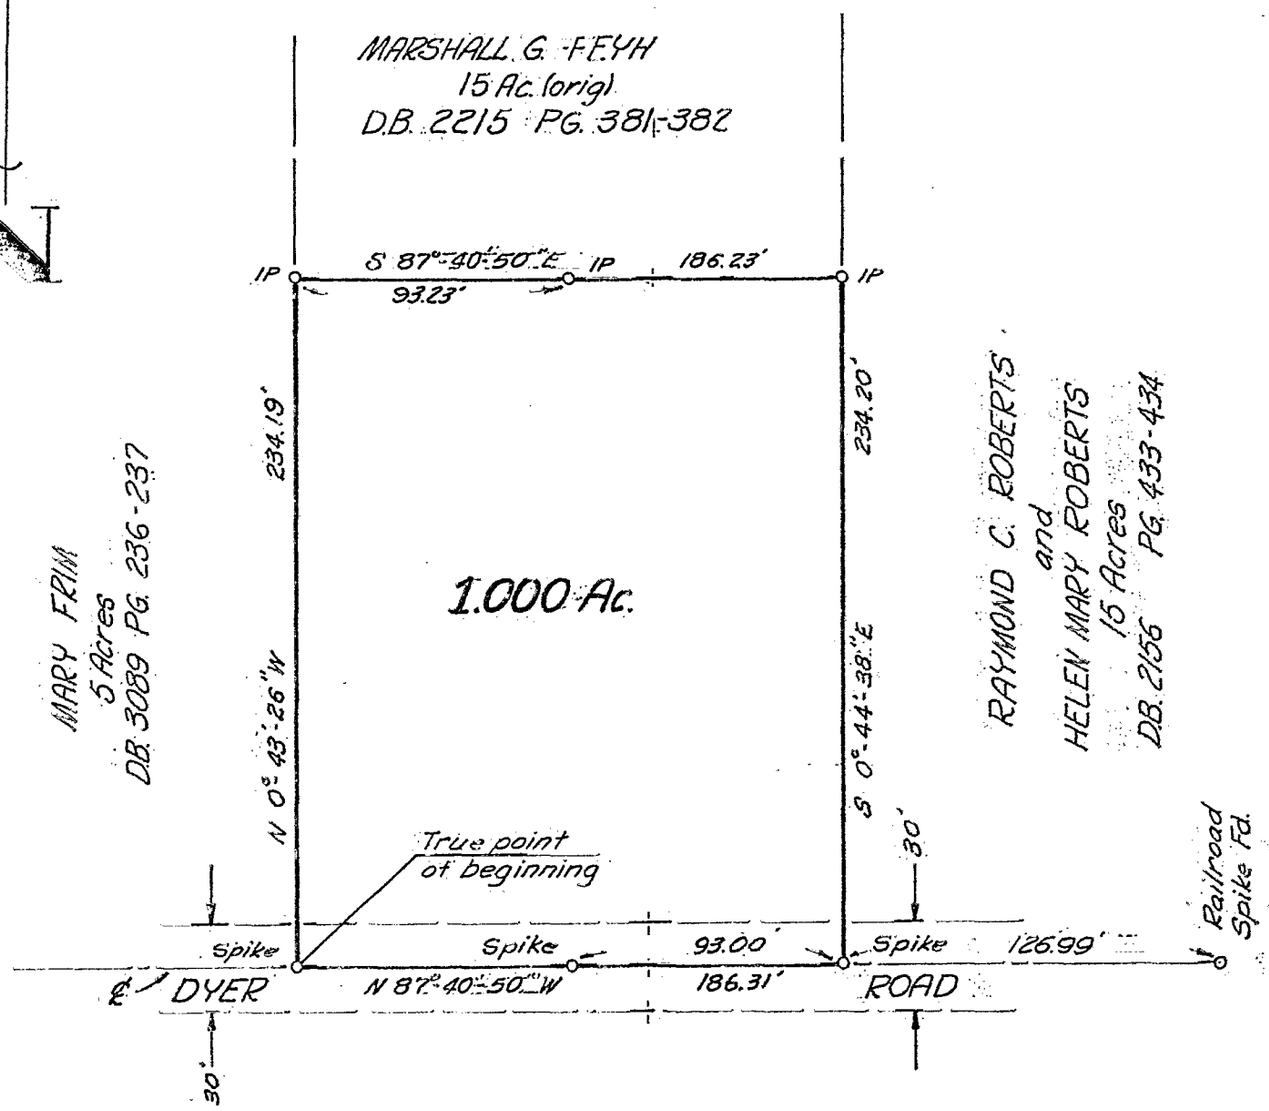

PLAT SHOWING 1.000 Ac. OUT OF
MARSHALL G. FEYH 15 Ac. TRACT DB 2215
PG 381-382 IN FRANKLIN COUNTY, OHIO

STATE OF OHIO
RICHARD G. GRASHEL
6002
REGISTERED
SURVEYOR

We hereby certify that the foregoing plat was prepared from an actual survey of the premises.

SCALE 1" = 60'

SURVEYED	DRAWN	CHECKED
L. A.	JW	R. G. G.

DATE: 12/22/72	P.456
REVISED DATES	ORDER NUMBER
2/8/73	

HOCKADEN-LIPES-ROUSCULP, INC.

By. Richard G. Grashel
Registered Surveyor 6002