


JACKSON TWP. R-32

03213

2357  
8355025

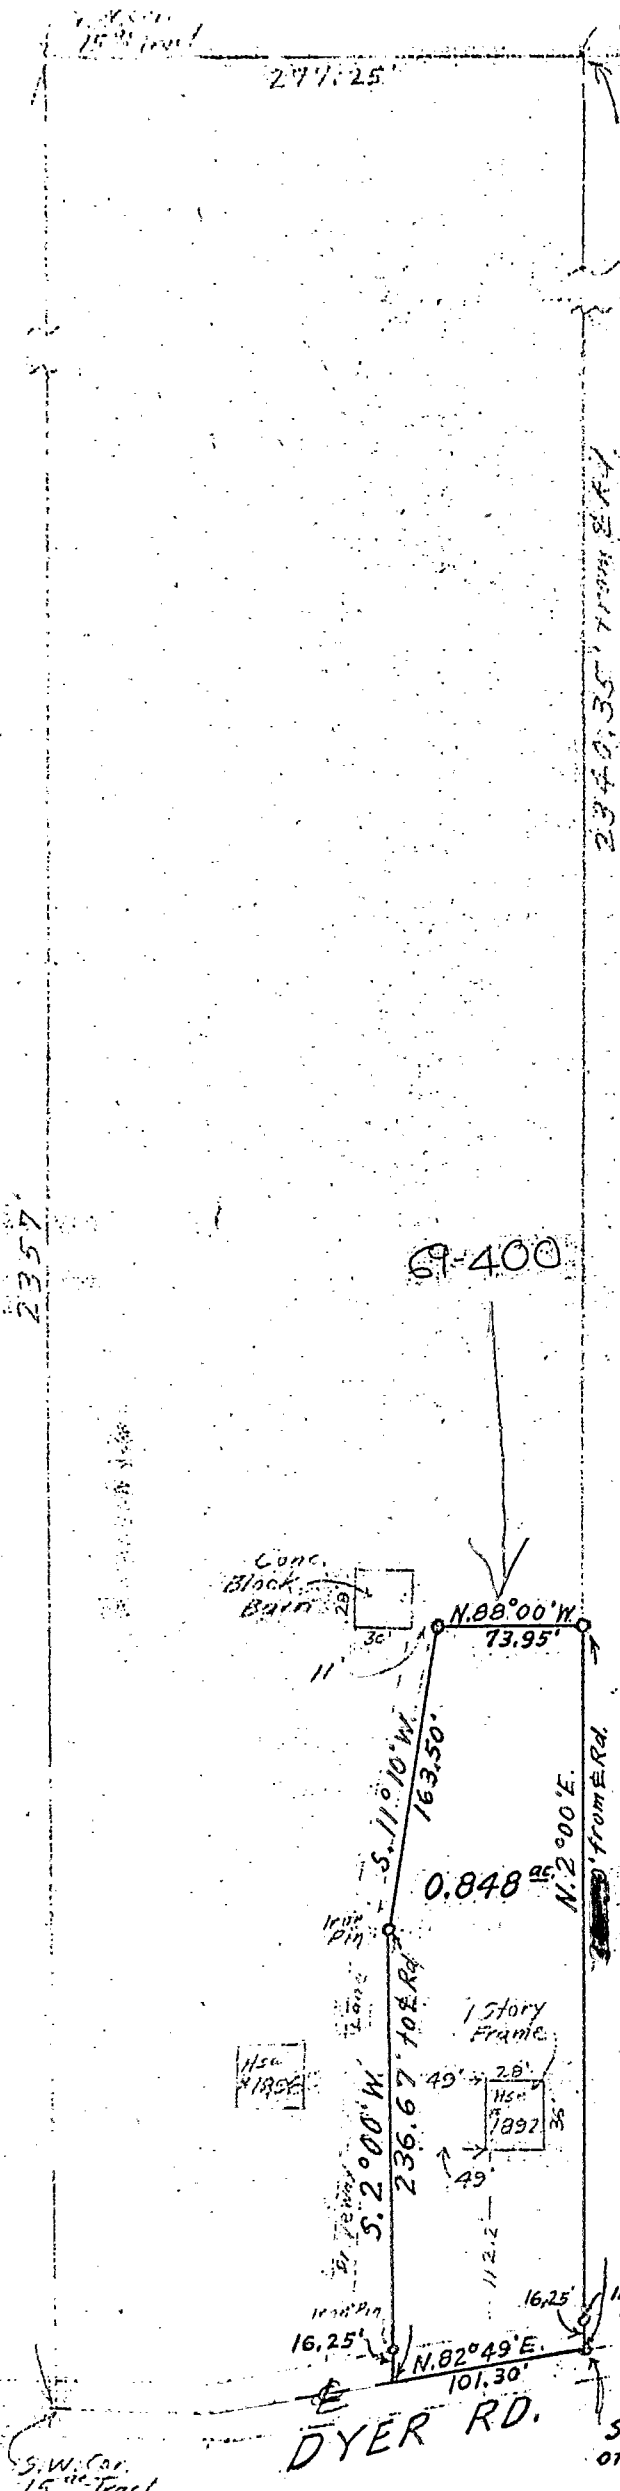

SURVEY OF 0.848<sup>ac</sup>  
 JACKSON TWP. FRANKLIN  
 SURVEY No. 6839 VIRGINIA MIL.  
 Scale, 1"=100' APR. 1962  
 Surveyed for  
 MR. RAYMOND C. ROBERTS

Being a part of Lot 1 of the  
 subdivision of John R. Brown's  
 as the same is recorded in the Prob  
 Court, Case No. 13212, M<sup>rs</sup> Guffey vs.  
 et al.

Being part of a 15<sup>ac</sup> tract  
 conveyed to Raymond C. & Helen  
 Roberts from Josephine M. & H.  
 G. Gantz, as recorded in Deeds  
 page 433, Franklin County, Ohio  
 records.

F. K. Harvey  
 Registered Surveyor #2570

