


Eileen Barbee & Judith A. Poenisch, Trustee
Parcel Number One
Lot 3
O.R. 1669, Pg. F18

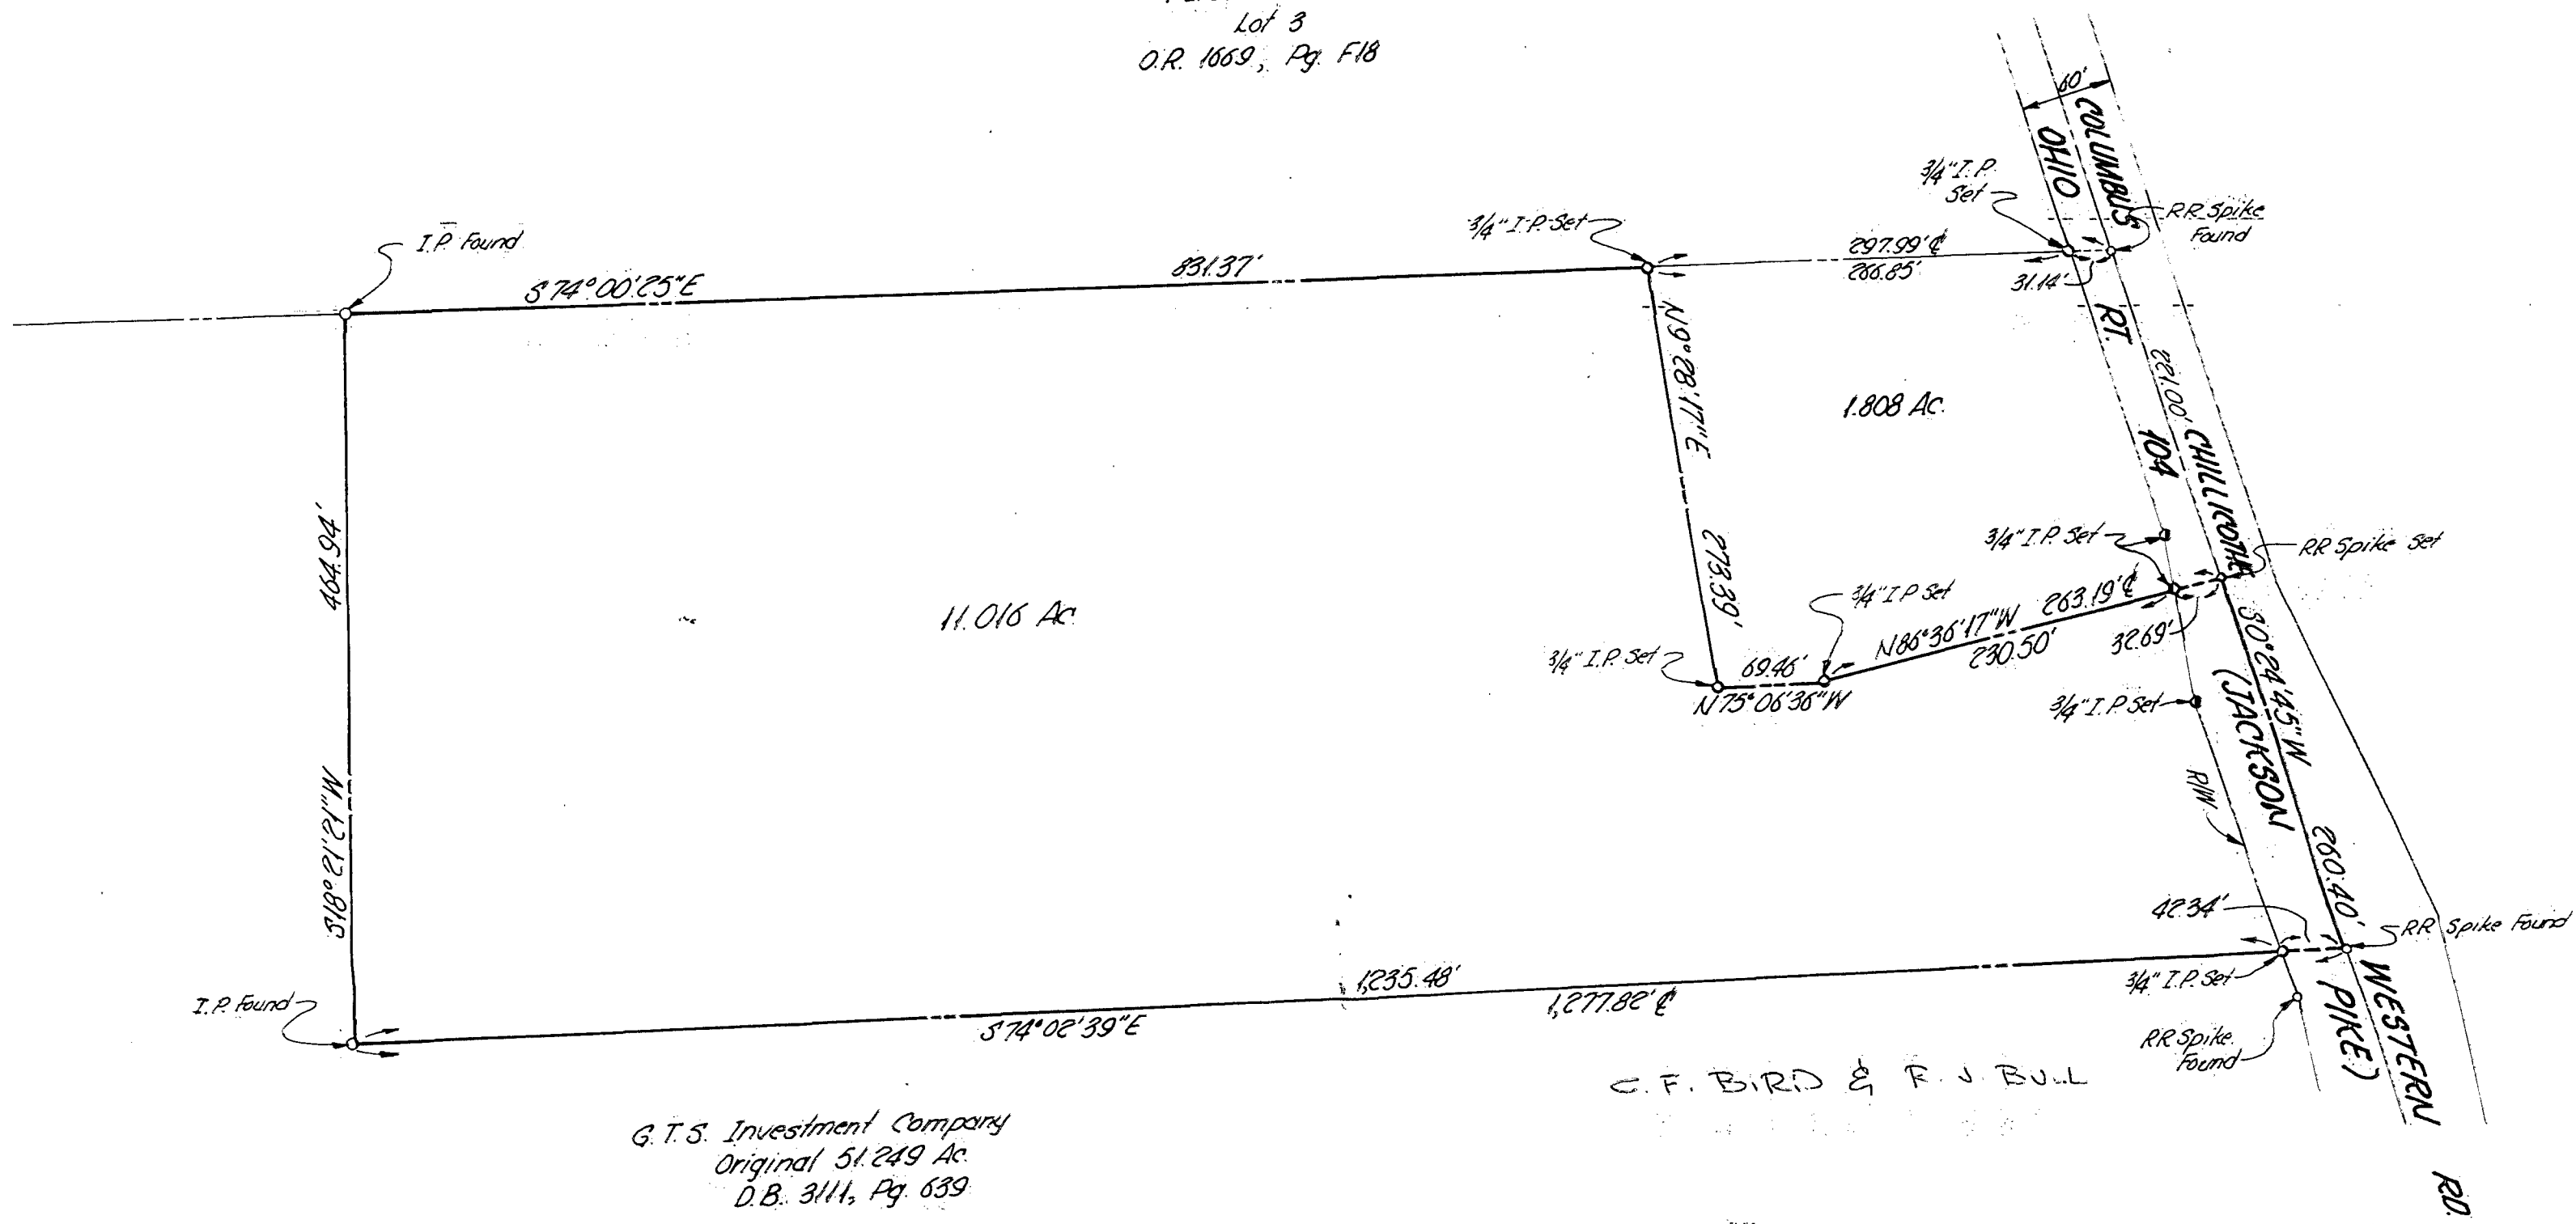

G.T.S. Investment Company
Original 51.249 Ac.
D.B. 3111, Pg. 639

C.F. BIRD & R.J. BULL