

18285 6875

MYERS SURVEYING CO.  
2140 East Main Street, Columbus 43209 (Bexley), Ohio

N-123


PARTITION OF LOT 40, HOME ACRES ADD'N. COLUMBUS, OHIO

For

WILLIAM R. & ARTHUR K. FRUSH

P.B. 16 Page 23  
Scale 1"=20'

Franklin Co. Rec. Office  
12-7-'84

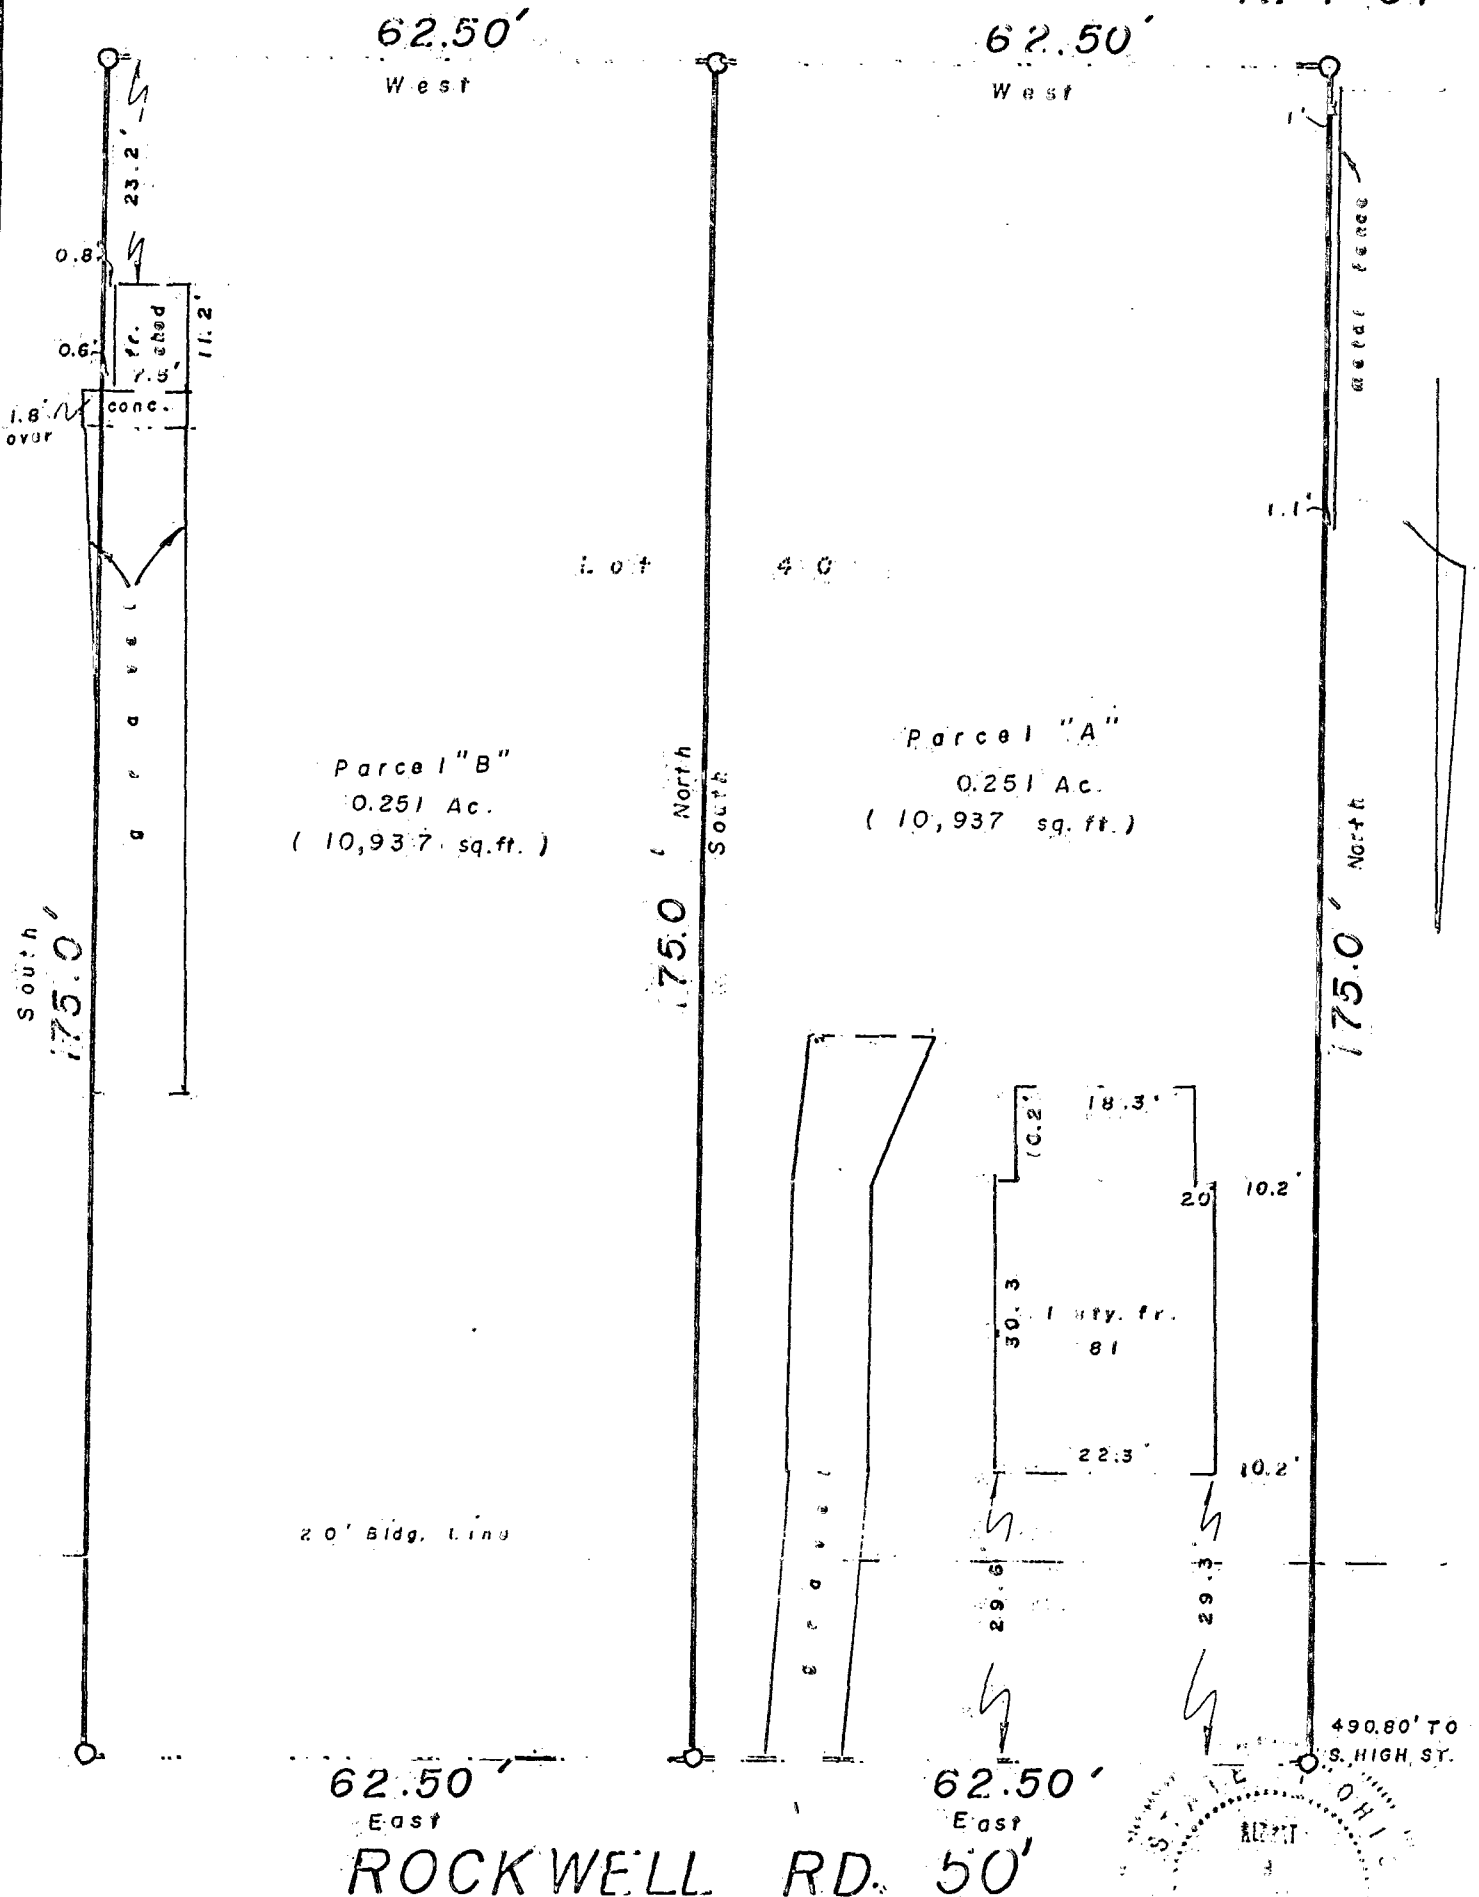

We hereby certify that the foregoing plat was prepared from an actual survey of the premises. No side line of principal building is less than dimension shown. Iron pins not set unless indicated thus -0-.

MYERS SURVEYING CO.

BY *Albert Myers*  
Registered Surveyor

