

70-104 to 70-101 incl.

X N-28-C


# DON V. BODENHEIMER — SURVEYOR

COLUMBUS, OHIO

LOT NO. \_\_\_\_\_ ADDITION \_\_\_\_\_

PARCEL NO. 1-2-3-A TOWNSHIP MARION

DEED BOOK NO. 2934 PAGE NO. 248 FRANKLIN COUNTY RECORDER'S RECORD

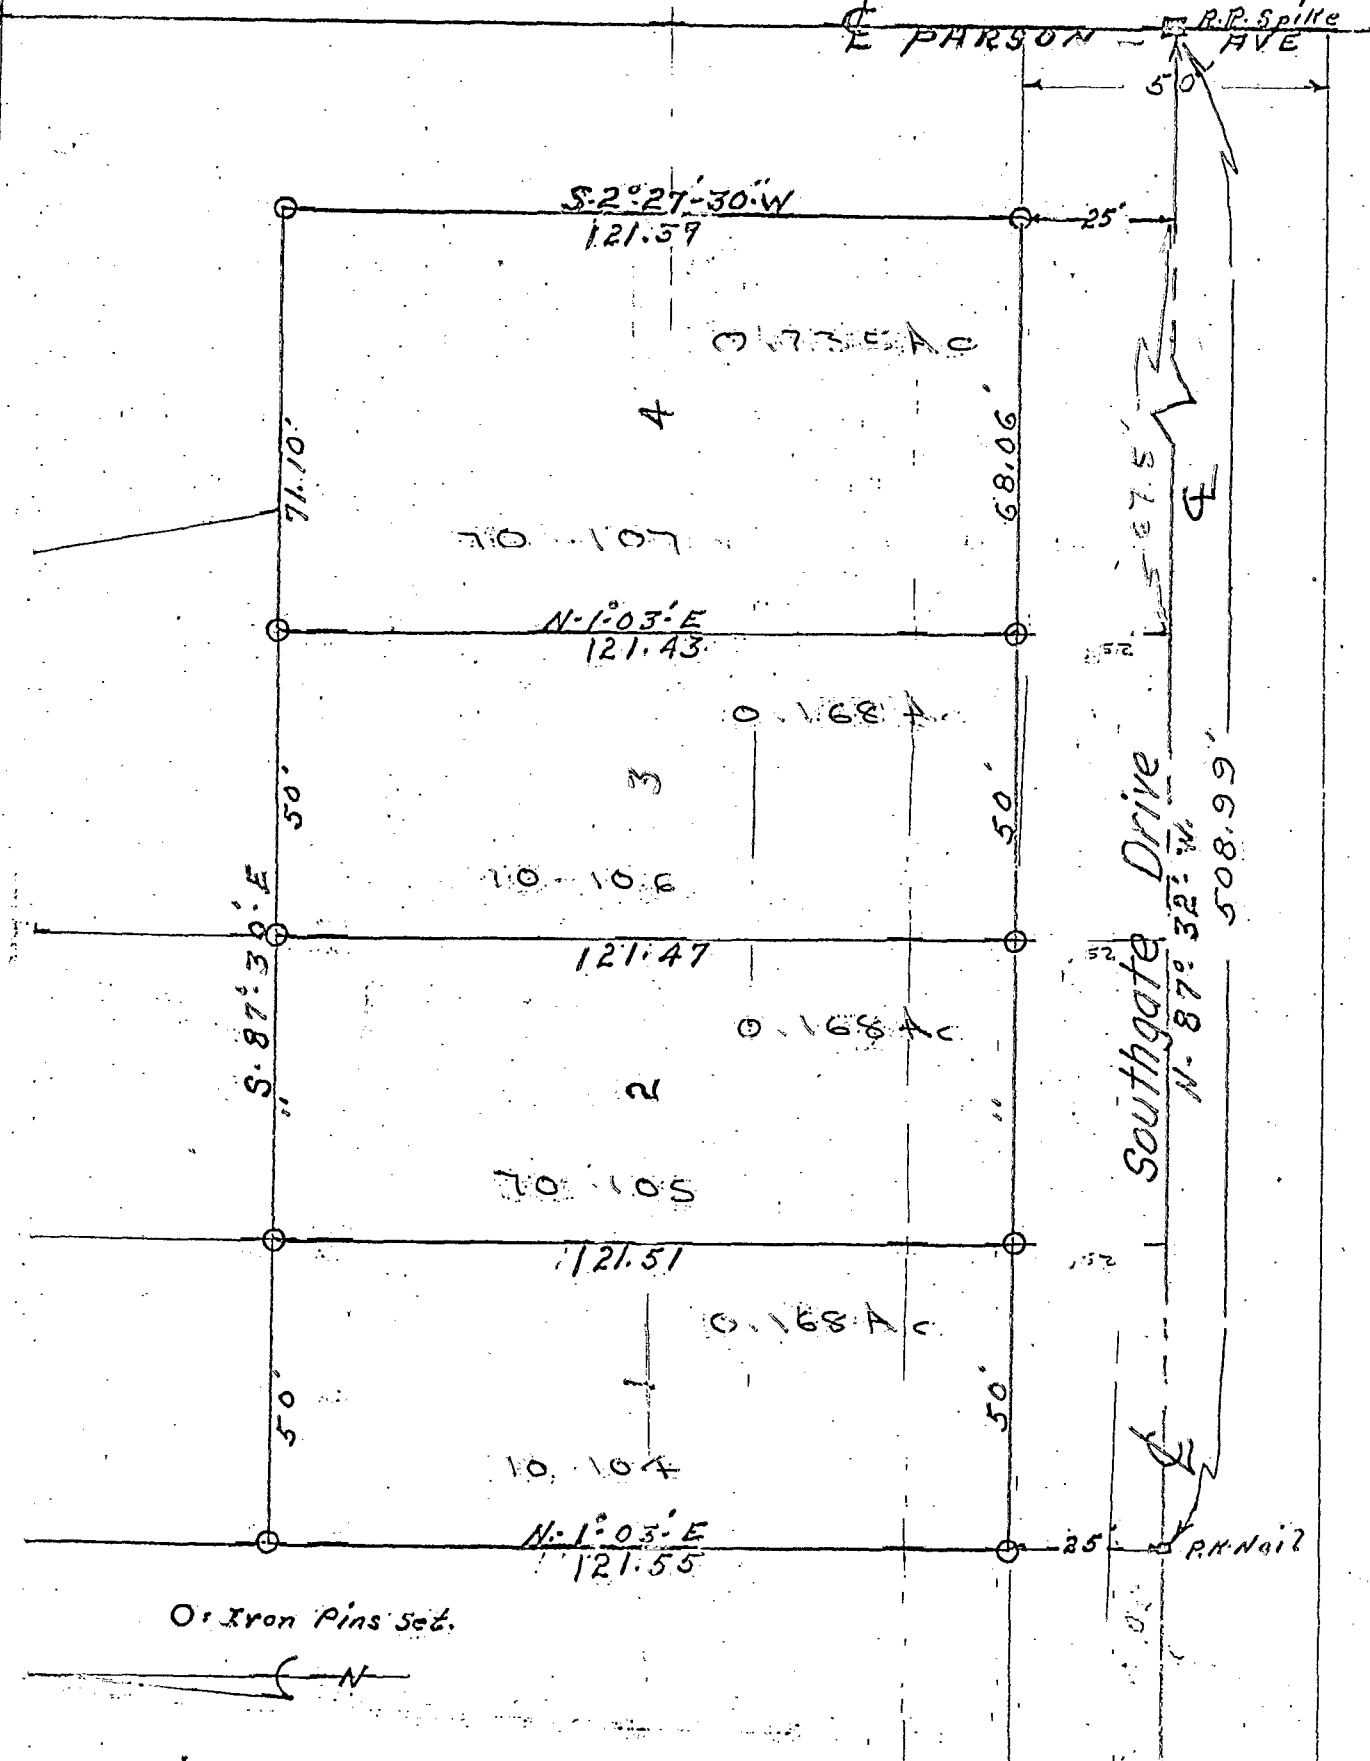

18316925  
N-28-C

SCALE: 1" = 30'		
DATE: Jan. 17, 1970		
SURVEYED BY D.V.B.	DRAWN BY D.V.B.	CHECKED BY J. A. T.

BY Don V. Bodenheimer  
REGISTERED SURVEYOR

Attorney w.w. Stevenson 228-5295 Don V. Bodenheimer A.S. #5046