HOCKADEN AND ASSOCIATES, INC.
CONSULTING ENGINEERS
883 N. CASSADY AVENUE
COLUMBUS, OHIO 43219
(614) 252-0993

179857075

M-72-A

EXHIBIT

SITUATED IN THE CITY OF COLUMBUS, COUNTY OF FRANKLIN, STATE OF OHIO, AND BEING PART OF SURVEY NO. 1425, VIRGINIA MILITARY DISTRICT, CONTAINING 0.4247 ACRE.

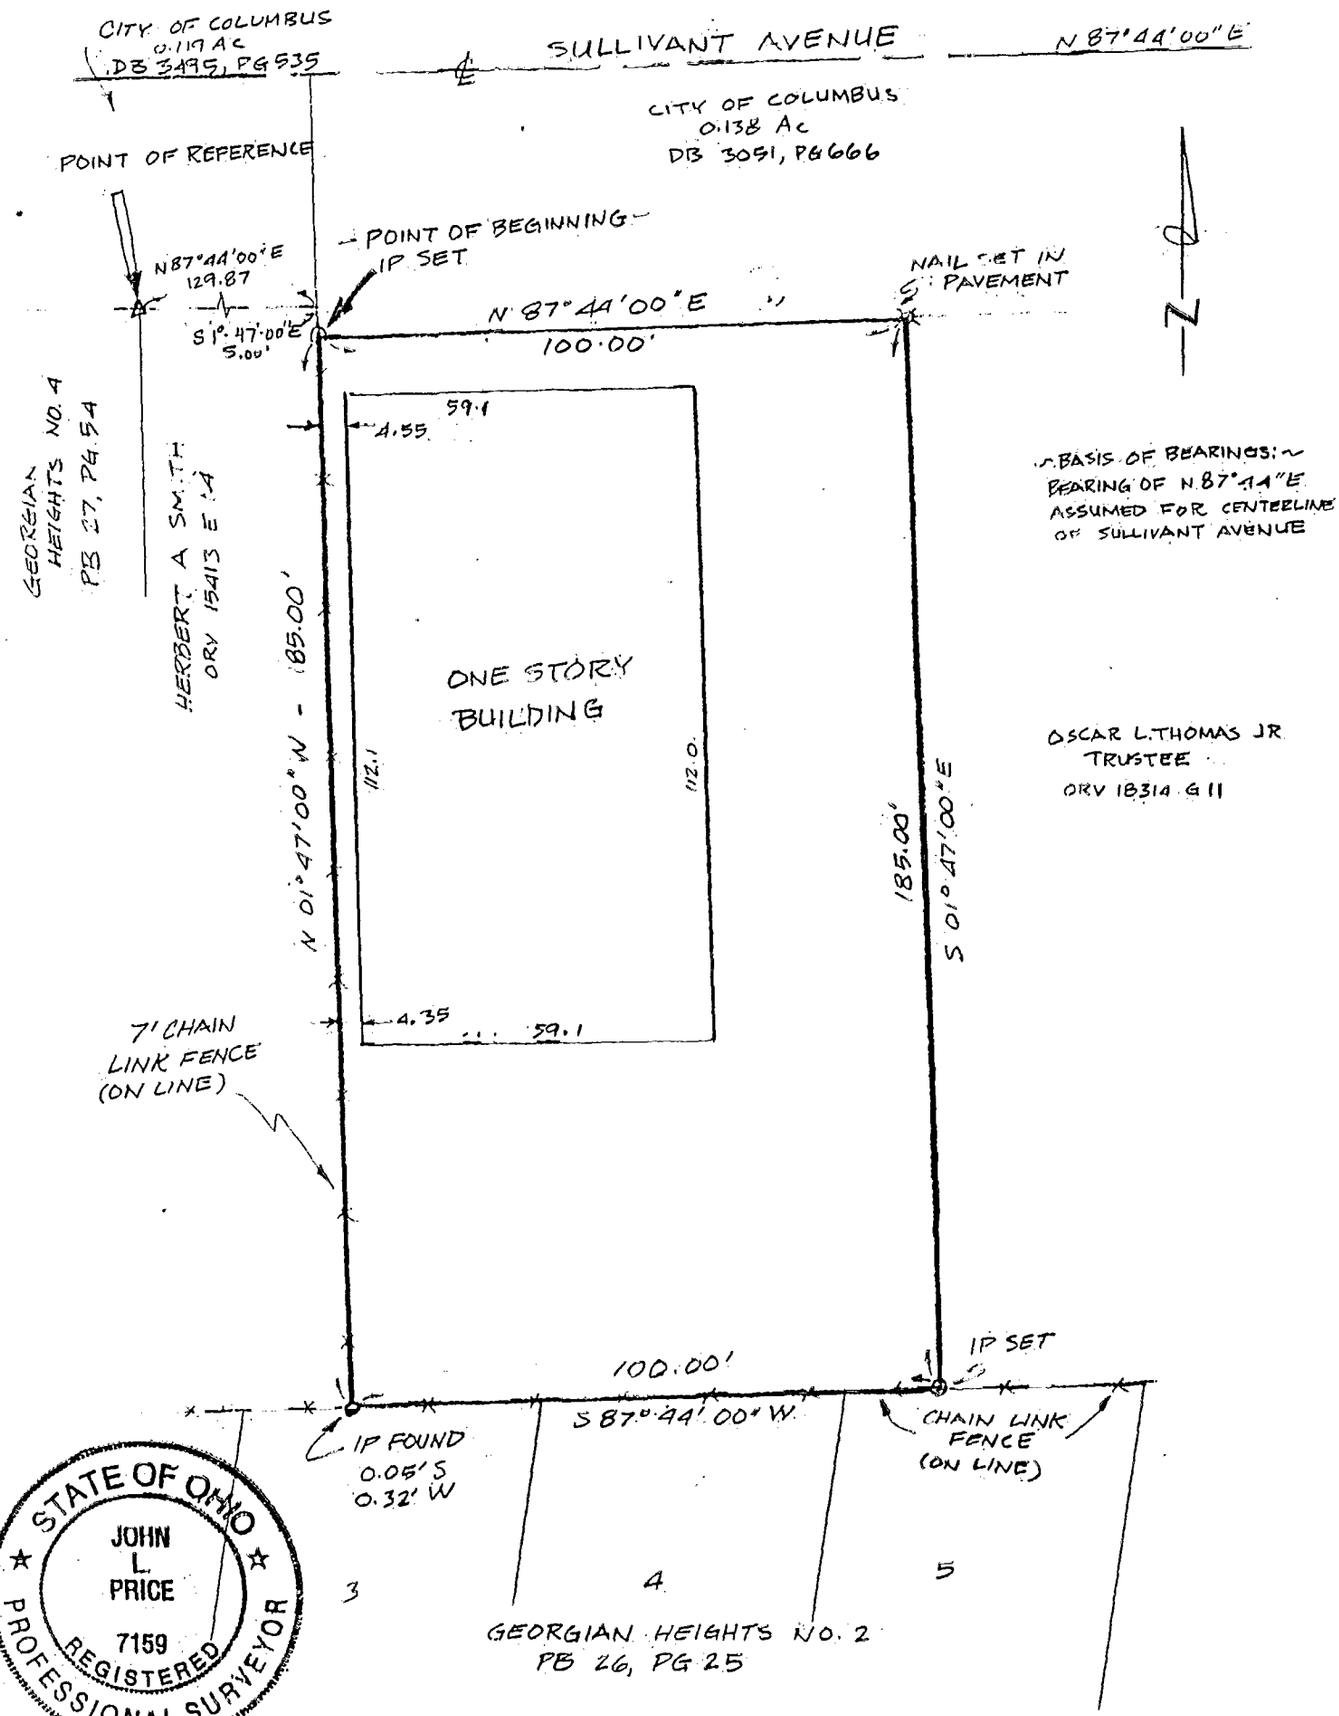

STATE OF OHIO
JOHN L. PRICE
7159
REGISTERED
PROFESSIONAL SURVEYOR

SCALE 1" = 30'

SURV'D.	DRAWN	CHECKED
BS	RF	

DATE: 10-02-92	39755
REVISED DATES	ORDER NUMBERS

HOCKADEN AND ASSOCIATES, INC.
CONSULTING ENGINEERS

By John L. Price 10/7/92
REGISTERED SURVEYOR 7159