

N-17

18360 6813

N 17

SURVEY FOR  
 GERALD R. STOVER  
 1090 WILLIAMS ROAD  
 SECTION 10, FRACTION 9, TOWNSHIP 4, RANGE 22, CONGRESS LANDS  
 CITY OF COLUMBUS (FRANKLIN COUNTY) OHIO

Scale 1" = 50' Date 6-22-78 P.B. . . . P. . . D.V. . . . P. . . Lot No. . . .

GLADYS B. HILL (L.E.)  
 D.V. 3013 P. 44

HAROLD K. PHILLIPS  
 GENEVA MAE PHILLIPS  
 (D.V. 2965 P. 94)

LEGEND  
 O IRON PIN


ROBERT I. KINCAID  
 EDNA L. KINCAID  
 (D.V. 3576 P. 202)

JOHN W. STIRE  
 VIRGINIA STIRE  
 (D.V. 3277 P. 321)  
 (D.V. 3650 P. 768)

0.904  
 ACRES

WILSON AVENUE

AARON A. SIDERS  
 MONA B. SIDERS  
 (D.V. 3555 P. 415)

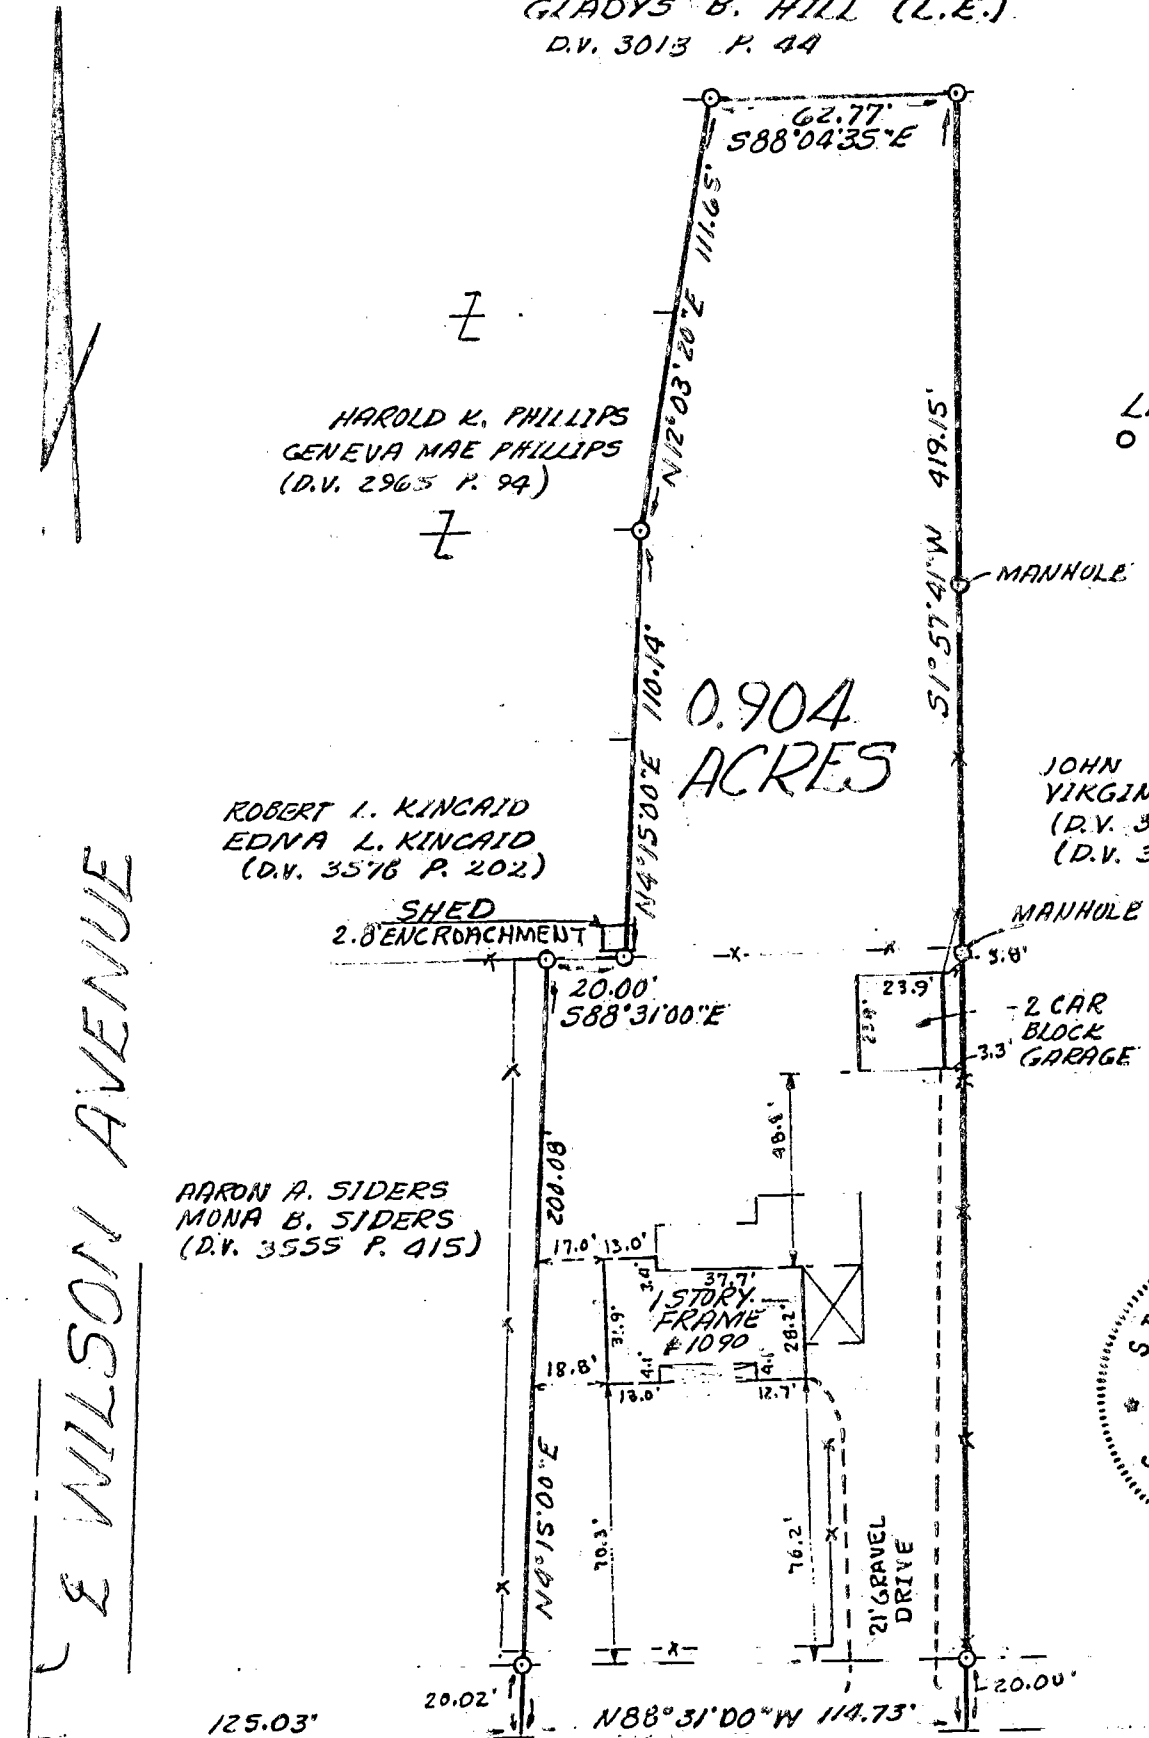

WILLIAMS ROAD (40')

I hereby certify that the foregoing drawing was prepared from an actual survey of the premises.

Drawn by C. J. D.

*Charles J. Destefani*

Registered Surveyor No. 5666

**DESTEFANI SURVEYING**  
 LAND SURVEYOR

811 North Hamilton Road  
 Gahanna, Ohio 43230  
 (614) 476-0333