.H
POINT SURVEYING
6202 Outville Road SW.
Pataskala, Ohio 43062-9526
Phone (614) 927-2474

BOUNDARY SURVEY

Situated in the state of Ohio, county of Franklin, city of Columbus, part of Section 14, Township 4, Range 22 of the Congress Lands. Also part of a 7.000 acre tract of land conveyed to Shottenstein Holding Company as in OR. 5252 C03, Franklin County.

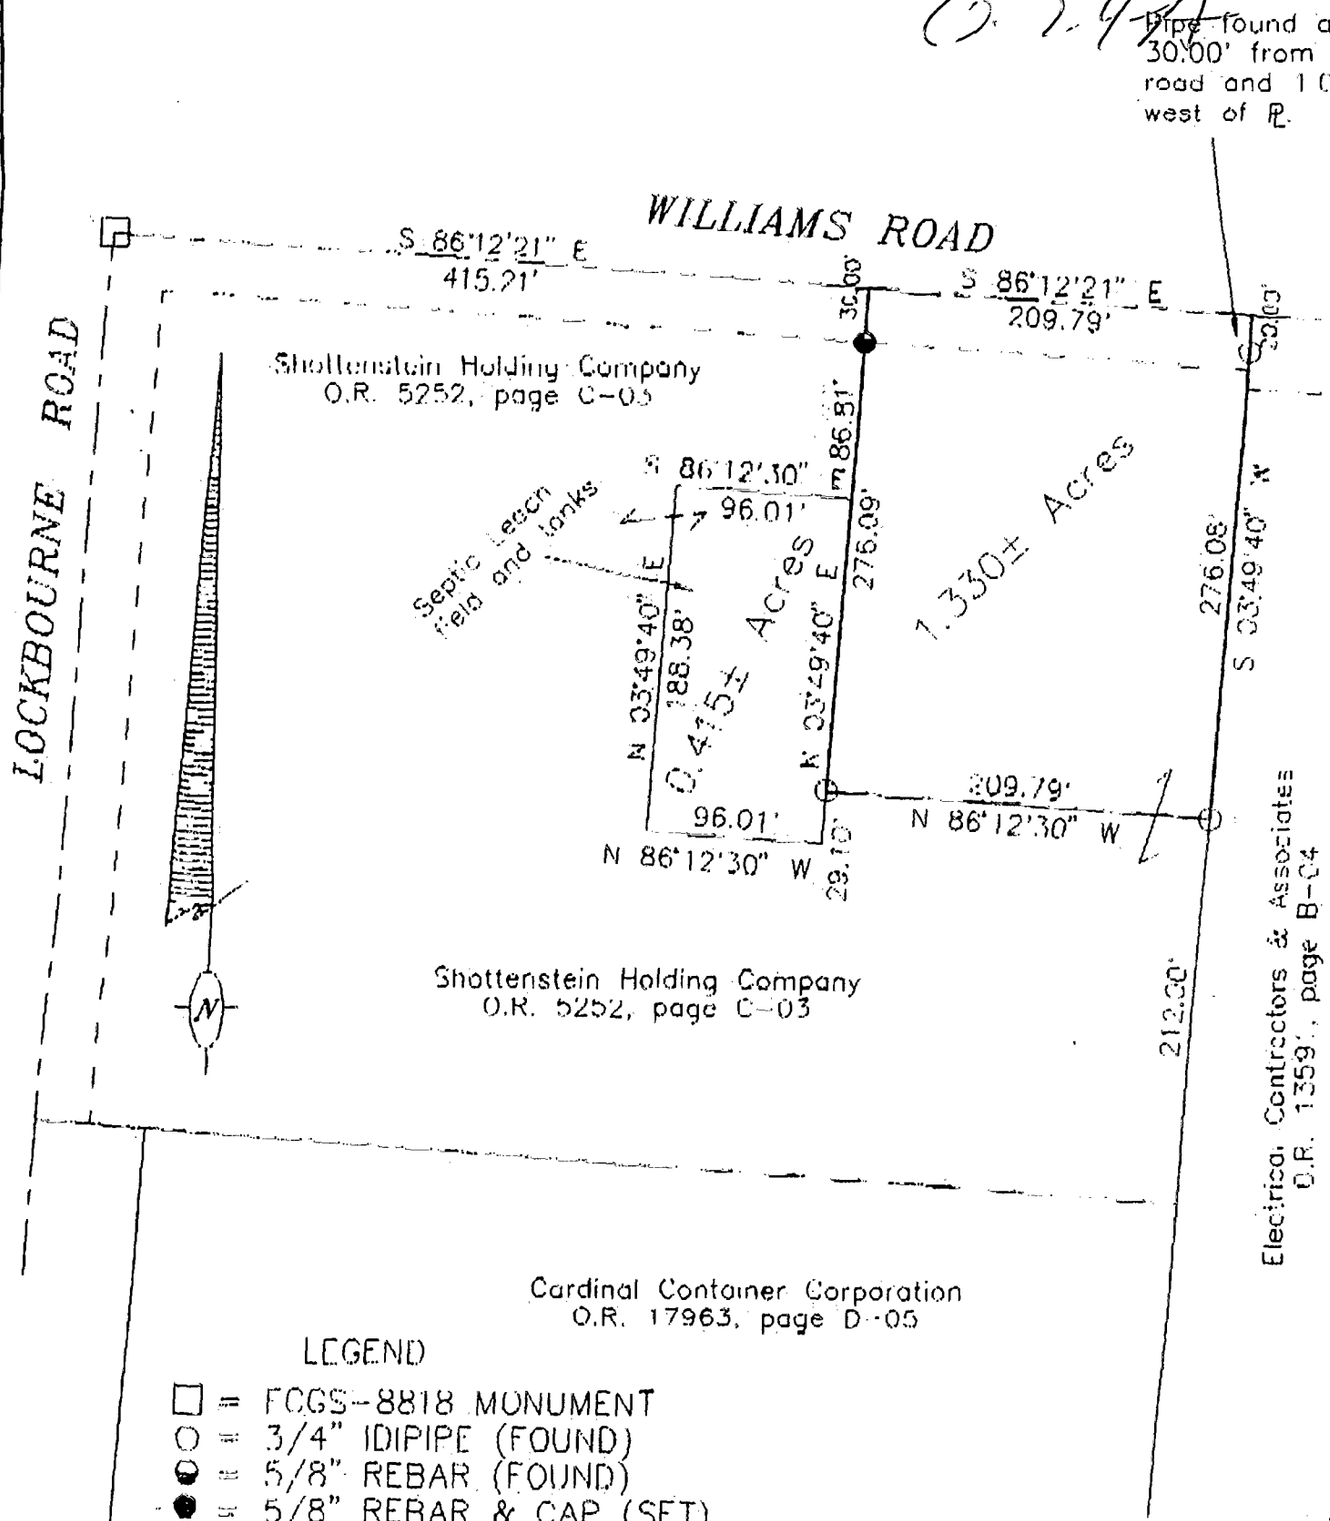

LEGEND

- □ = FCGS-8818 MONUMENT
- ○ = 3/4" IDIPIPE (FOUND)
- ◐ = 5/8" REBAR (FOUND)
- ● = 5/8" REBAR & CAP (SET) STAMPED "S 7081"

SCALE 1" = 100'

0 50' 100' 200

BY _____
Professional Surveyor
MARK BERRY # 7081

STATE OF OHIO
MARK A. BERRY 7081 REGISTERED
LAND SURVEYOR

DATE 11/07/95

Bearings for this field Survey are based on Franklin to and a meridian established between FCGS 8818, and FCGS 2260 established by Franklin County Engineer 1991.

951102

O-24-A
HAMILTON
'83 6068 87