18410.6825
18410.6850

MYERS SURVEYING CO.

2740 East Main Street, Columbus 9 (Bexley), Ohio

PART OF LOT 14 SCIOTO ADDN. OBETZ, OHIO

FOR

J. BELL REAL ESTATE

P.B. 7 Page 498
Scale 1"=25'

Franklin Co. Rec. Office
8 7 72

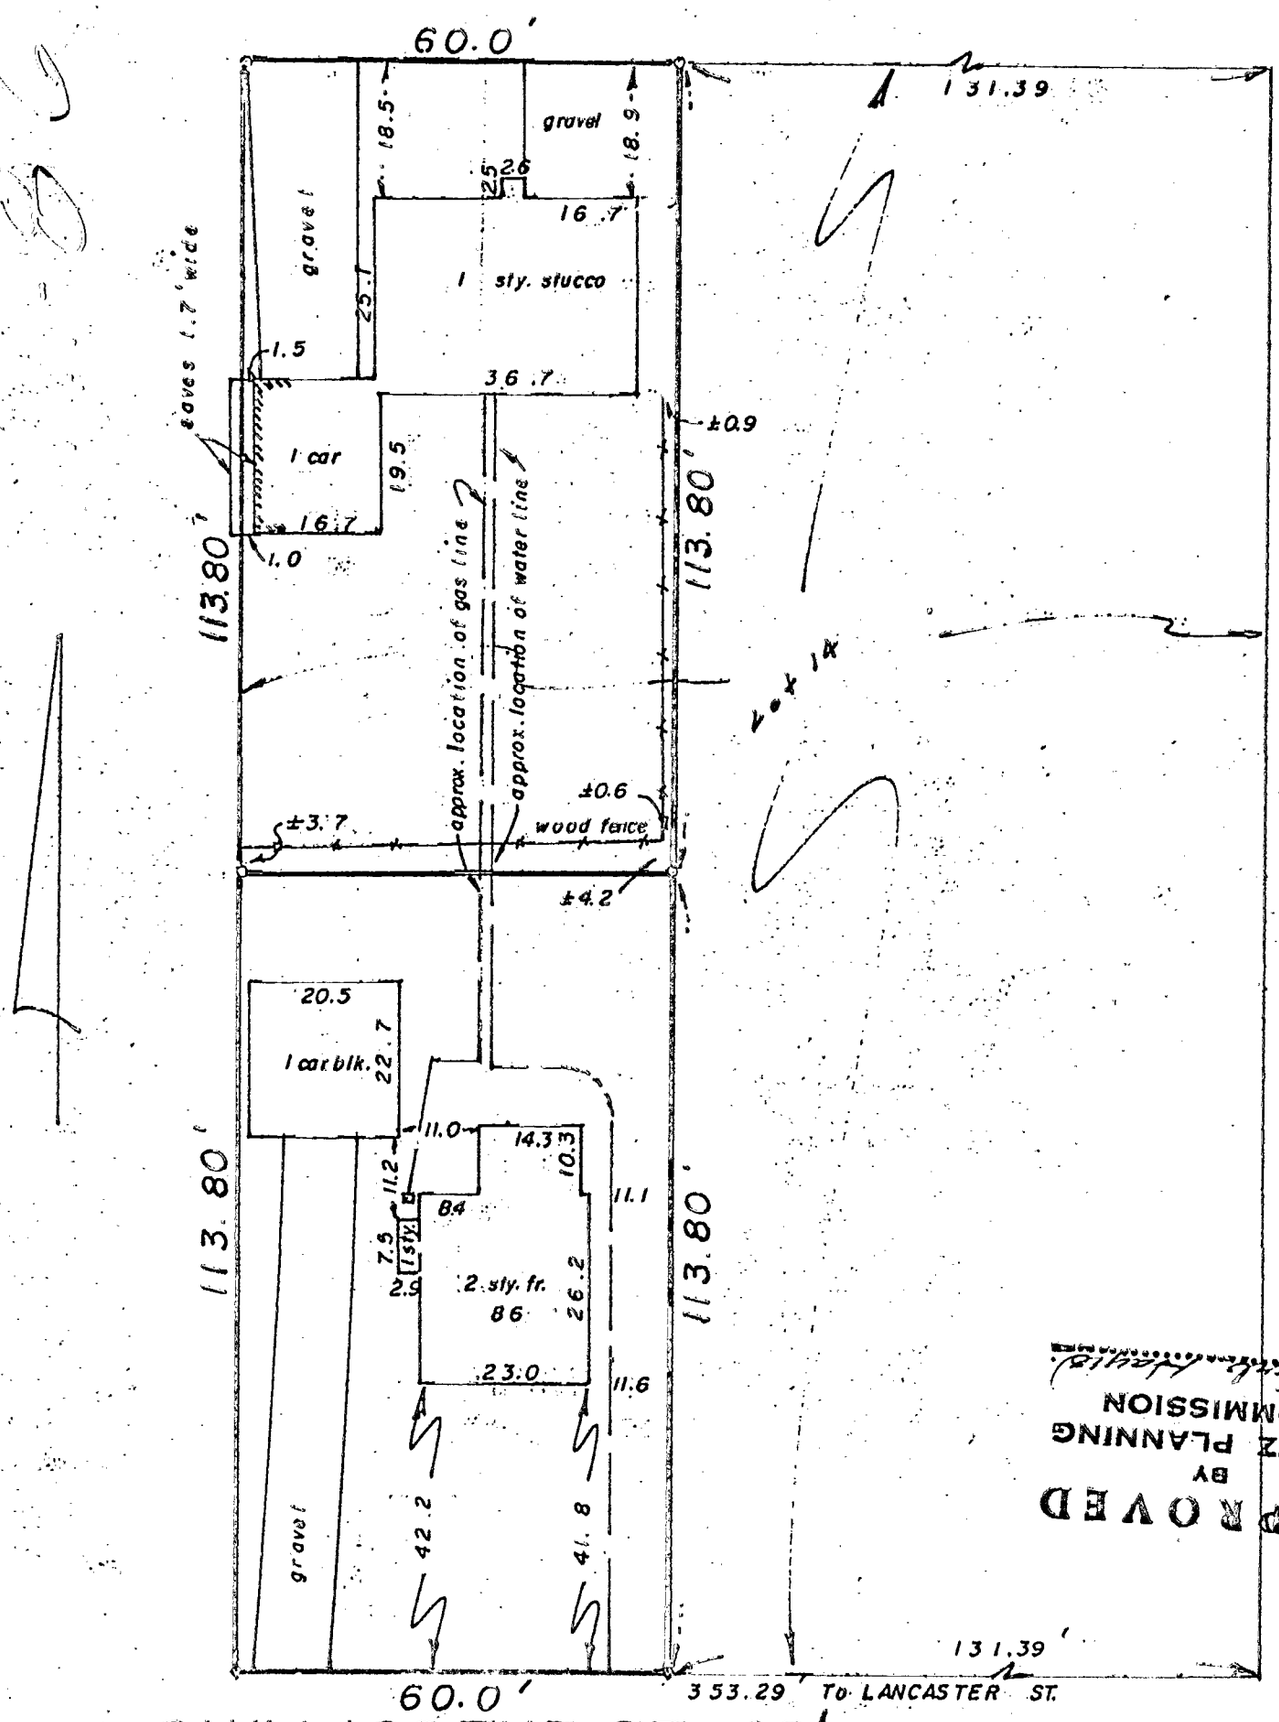

APPROVED
BY
OBETZ PLANNING
COMMISSION
BY

We hereby certify that the foregoing plat was prepared from an actual survey of the premises. No side line of principal building is less than dimension shown. Iron pins not set unless indicated thus —0—.

MYERS SURVEYING CO.
BY
Registered Surveyor

2730-72

F	D	L	C