

256.12

HAM LTON TRAP

84106850

JAMES F. NUCKLES TR.

WILLIAMS


ROAD

84356852

DB 2702 Pg. 584

Note:

of Electric Easement  
Located in Field as @  
between Two Transmission  
Lines.

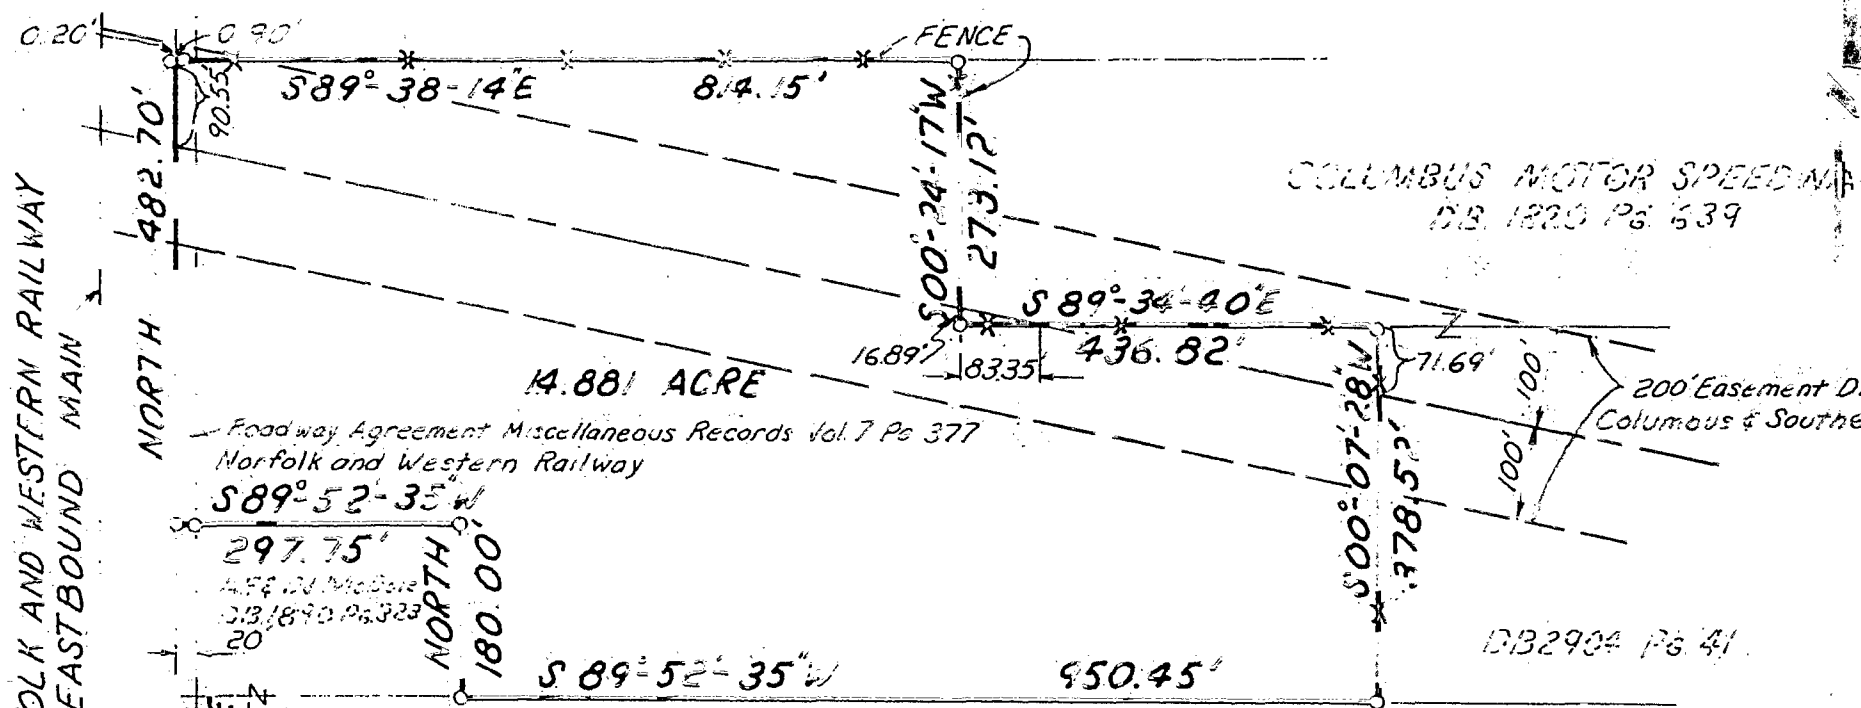

NORFOLK AND WESTERN RAILWAY  
EASTBOUND MAIN

NORTH

Roadway Agreement Miscellaneous Records Vol. 7 Pg. 377  
Norfolk and Western Railway

S89°52'35\"

297.75'

159 24 Moore  
DB 1890 Pg. 323

20

PINE DRIVE  
VILLAGE OF OBETZ  
DB 2825 Pg. 85

NORTH  
180.00'

S89°52'35\"

950.45'

ELKS ACRES SUBDIVISION  
SECTION 1

IRON PIN SHOWN THUS: —○—

14.881 ACRE TRACT  
PART OF NW QUARTER, SECTION 13, TWP. 4, R. 22,  
MATTHEWS SURVEY, CONGRESS LANDS  
VILLAGE OF OBETZ  
FRANKLIN COUNTY, OHIO  
FOR

MR. JOHN S. MITCHELL

SCALE: 1"=200'

DECEMBER 13, 1974

THE JENNINGS-LAWRENCE CO.  
Civil Engineers and Surveyors  
555 Buttes Avenue  
Columbus 15, Ohio

By E. J. Underwood  
Registered Surveyor

270.74

1840 120 069 082 W ALUM CREEK DR 1974 0240 030

250