


O-54-F

28 2524

Daniel & Margaret Sherman


0.736 ac.
DB. 3453 7y. 687

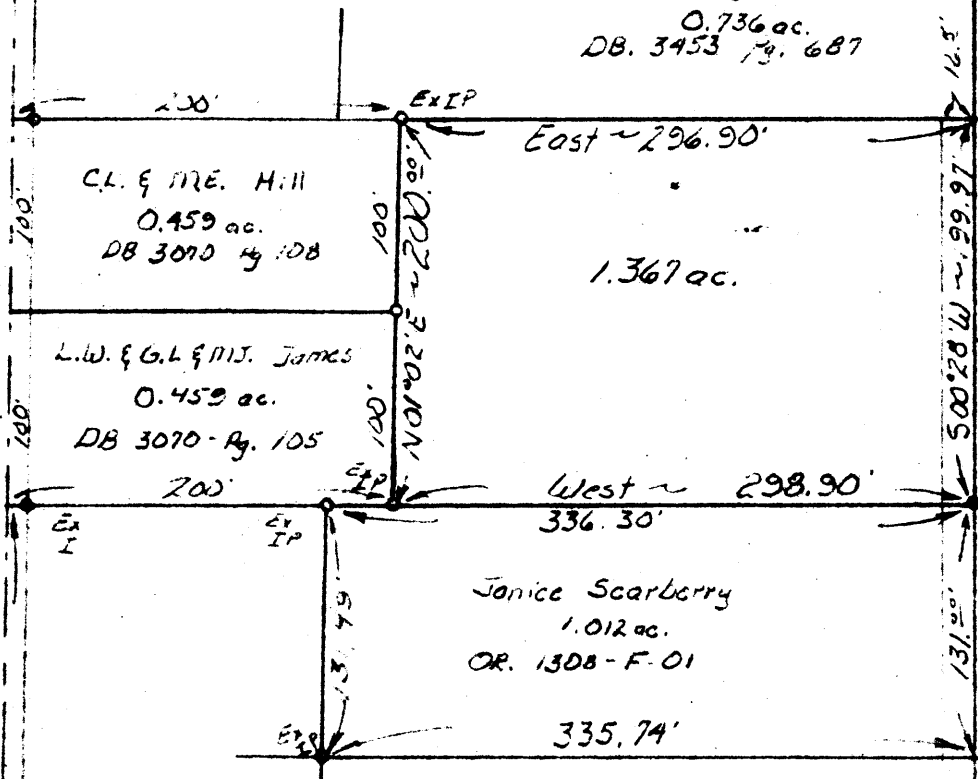

Elizabeth & Joseph Bodurine
1.0 ac.
DB. 1569 7y. 139

E Behm Road
637.6'

For Definition See: 1/6 corner Imp. Road Record #1
B. 4 thru 10 - 1883
Strack Rd 16.5'

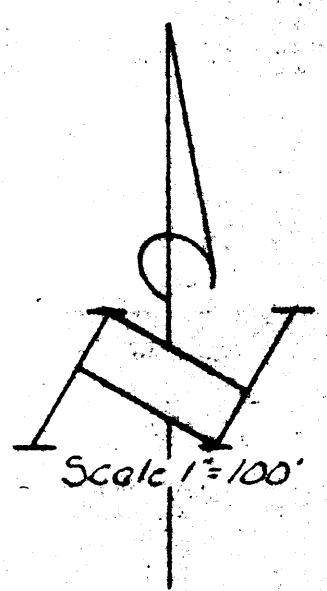


1/4 SE corner
SW 1/4
Section 12

South Line Section #12
Williams Road
497.84'

Survey of 1.367 acres
in section #12, Twp. #9, Rge. #22
in the City of Columbus, Franklin Co.
Ohio: For

Janice Scarberry

Louis F Haines

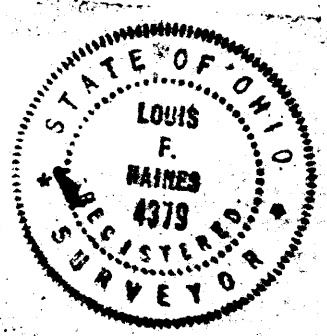

254 Kessler Street
Groveport, Ohio 43125
Phone 837-2181

I HEREBY CERTIFY THE PLAT SHOWS HEREON
IS CORRECT AS SURVEYED BY US.
DATE: May 20, 1984
SIGNED: Louis F. Haines