

MYERS SURVEYING CO.
 2740 East Main Street, Columbus 9 (Bexley), Ohio

JACKSON TWP.


BEING 0.778 AC. IN SURVEY # 1383, VIRGINIA MILITARY LANDS, JACKSON TWP., FRANKLIN CO.

FOR
OHIO BAR TITLE
 AND/OR
NATIONAL HOMES ACCEPT. CORP.

DB. 1865 Page 597
 Scale 1" = 40'

Franklin Co. Rec. Office
 9-10-77

0-33-B

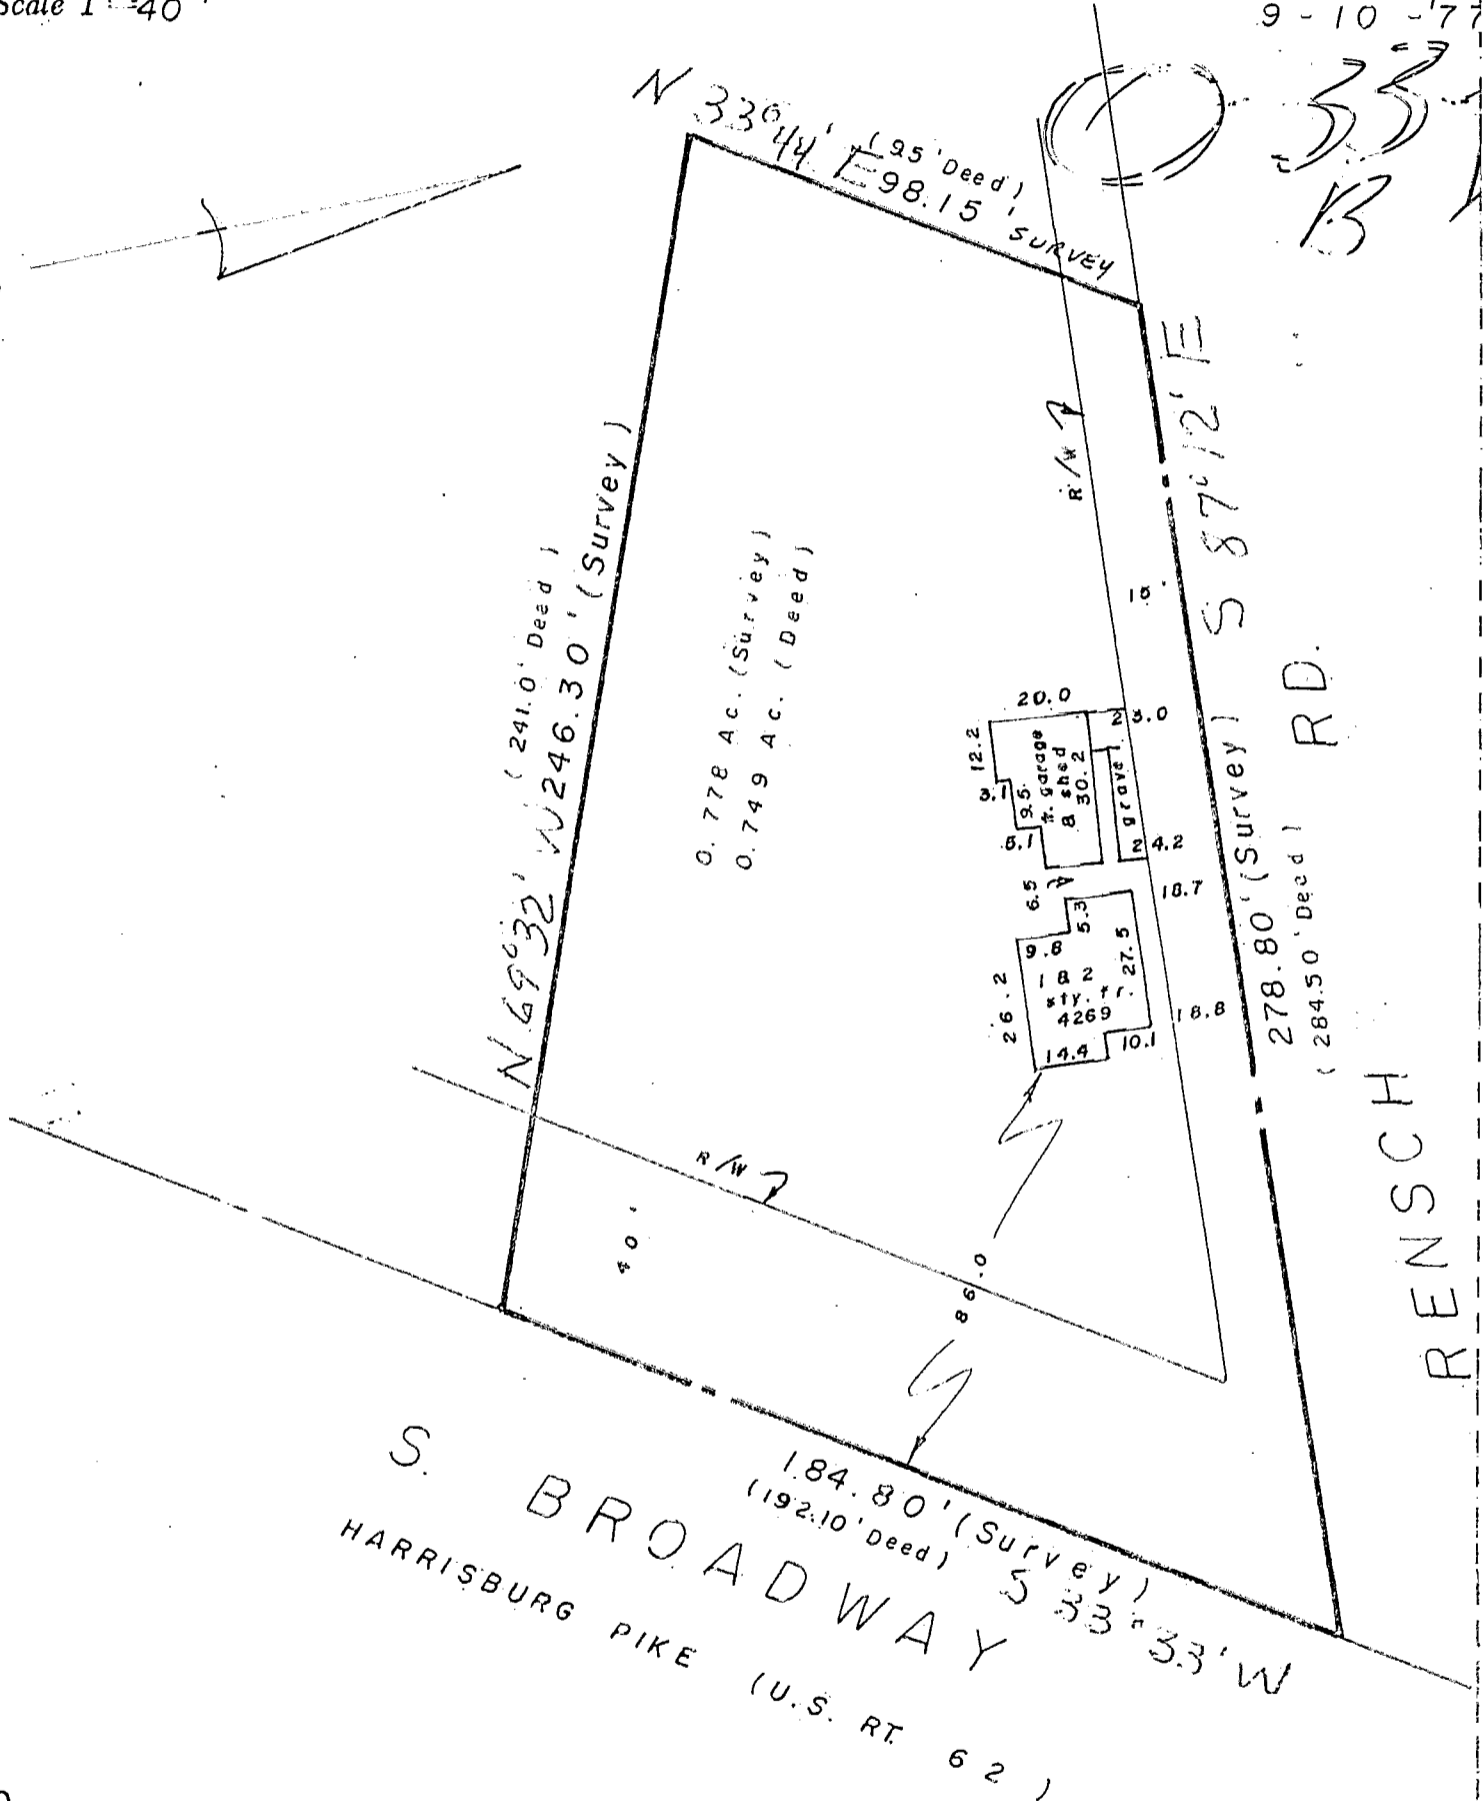

030
 0332
 1977
 RENSCH RD
 120
 2000

NOT TO BE USED TO ERECT FENCES.

We hereby certify that the foregoing plat was prepared from an actual survey of the premises. No side line of principal building is less than dimension shown. Iron pins not set unless indicated thus -0-. For Mortgage Loan & Title Insurance purposes only.

MYERS SURVEYING CO.
 BY *[Signature]*
 Registered Surveyor

DORAN

6-9-7-77

