80 35 800

SURVEY PLAT OF A 1.9987 Ac. TRACT
FOR THE ESTATE OF EMMA RANKE

SITUATED IN FRANKLIN COUNTY, JACKSON TWP, STATE OF OHIO.

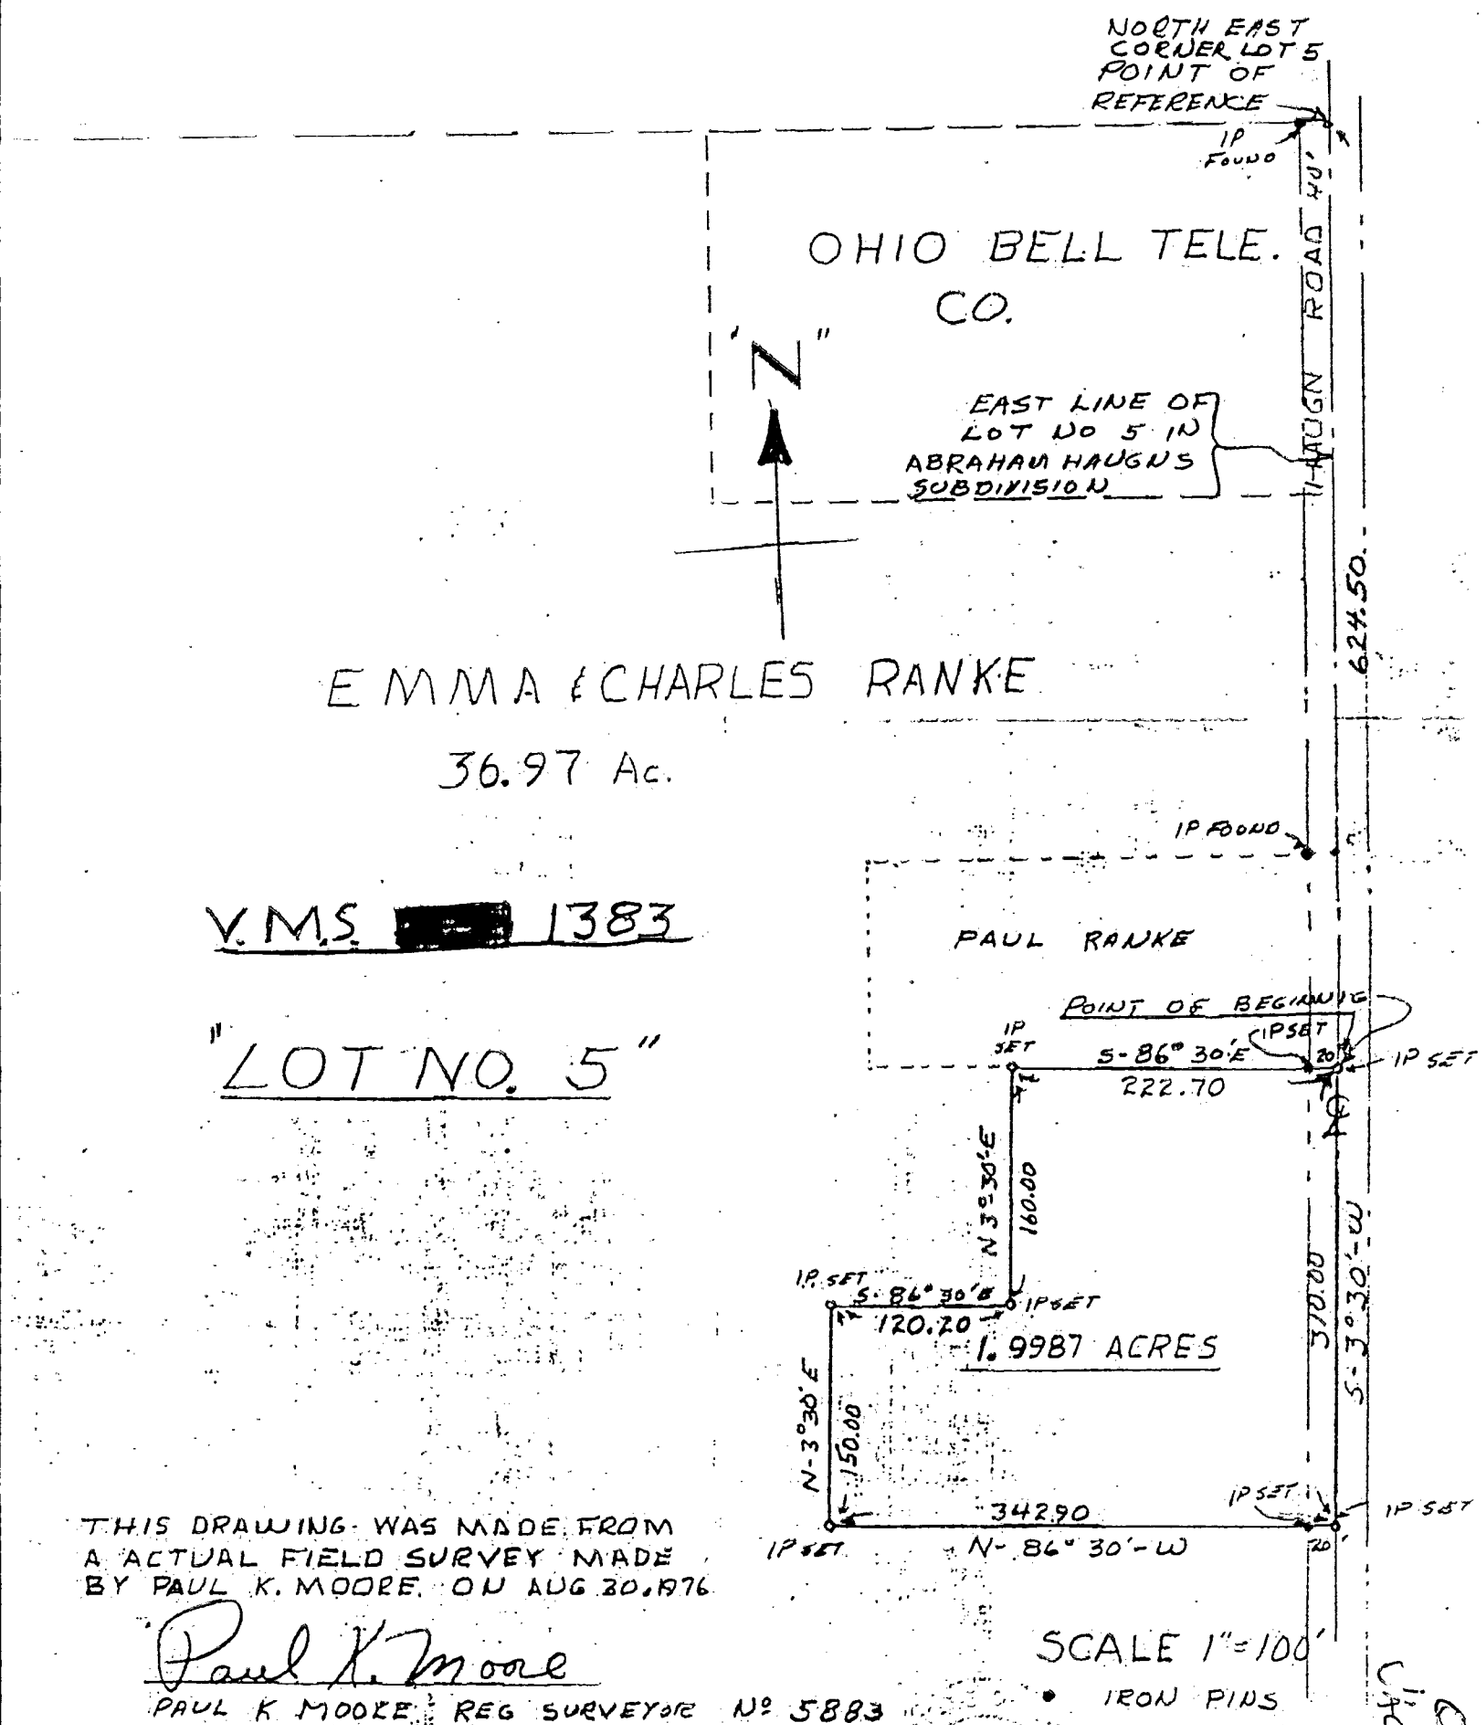

THIS DRAWING WAS MADE FROM A ACTUAL FIELD SURVEY MADE BY PAUL K. MOORE ON AUG 30, 1976

Paul K. Moore

PAUL K MOORE REG SURVEYOR Nº 5883

SCALE 1" = 100'

• IRON PINS

0-33-3

Jackson Twp