

ALLEN E. McDOWELL'S
 STRINGTOWN ROAD
 #3
 PARCEL PLAT

Allen E. McDowell
 5742 Dublin Rd
 Phone: FR. 2-8311




Lewis E. Keller 34.05 Ac.
 NORTH



28.654 Ac.

Charles L. & Ester E. Geyer 57.86 Ac.

Survey of Acreage Tracts
 Part of Lots 4 & 5 of E.W. Gwynne's Subdivision
 of Survey No. 8231 in Virginia Military Lands
 Twp. of Jackson, County of Franklin, State of Ohio
 Date: March, 1947 Scale: 1" = 200'
 □ = Concrete Post ○ = Iron Pipe ● = R.R. Spike

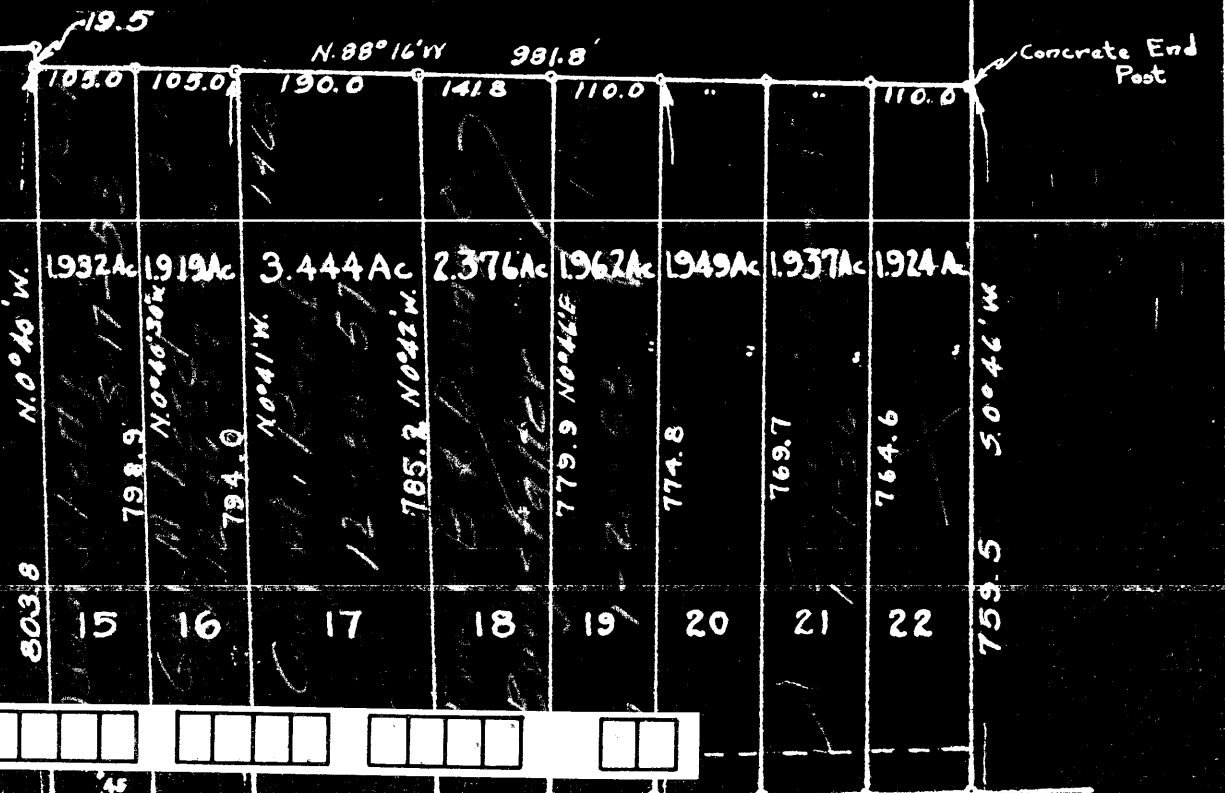

A. J. Davis
 Reg. Surveyor #483

