

180356775

M 830-1375

CHARLES H. BOYER - SURVEYOR

1370 PEGWOOD DR. COLUMBUS, OHIO 43229

PH. 885 - 3715

LOT NO. 4


ADDITION HAUGHN HEIGHTS P.B. 37, P. 67

PARCEL NO. \_\_\_\_\_

TOWNSHIP JACKSON

DEEDBOOK NO. 3056 PAGE NO. 542

FRANKLIN COUNTY RECORDER'S RECORD

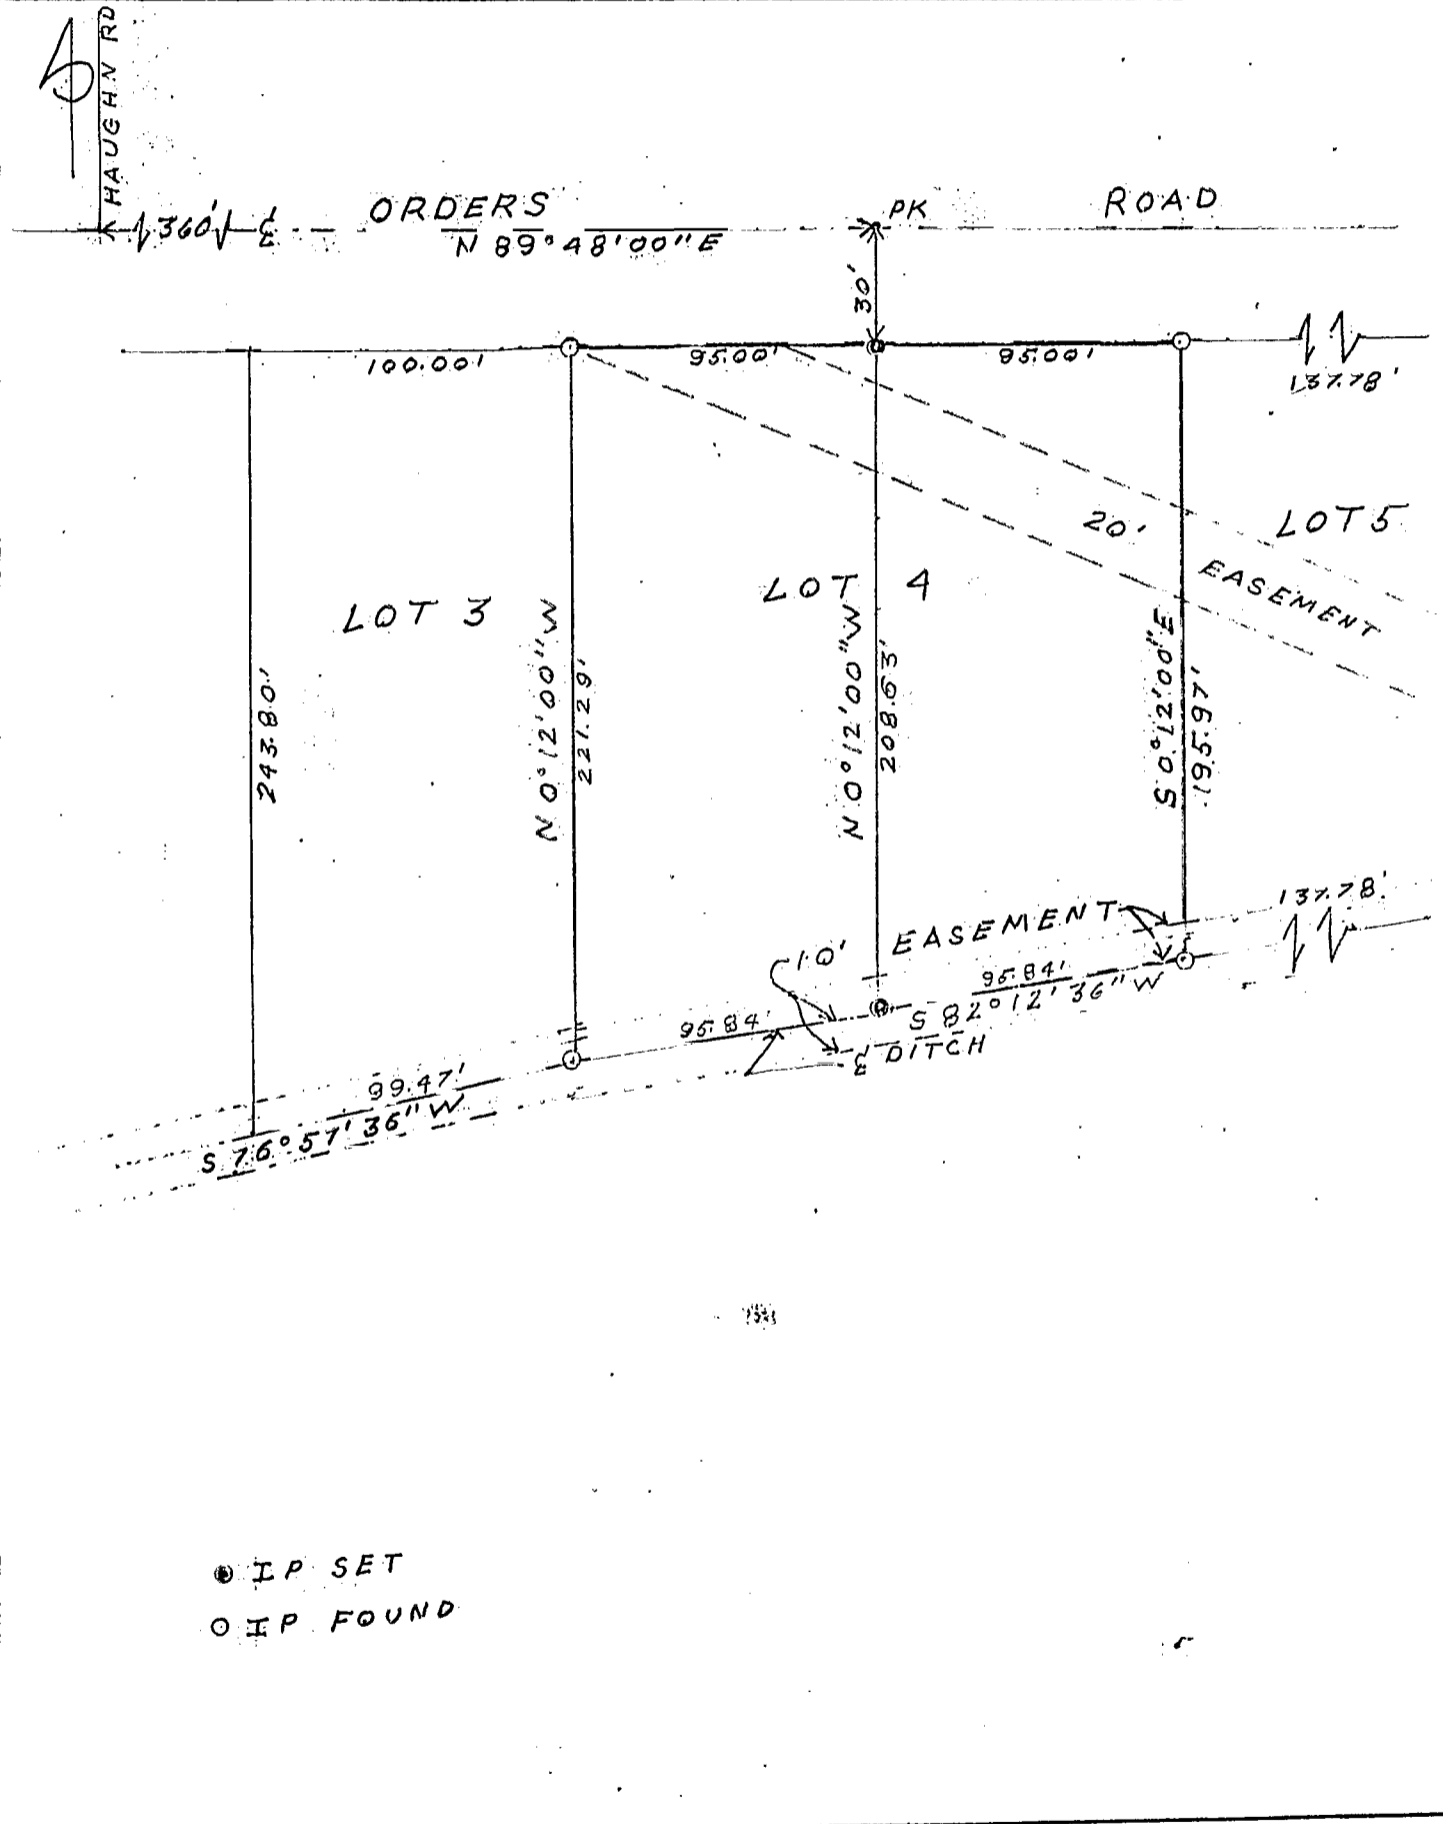

I HEREBY CERTIFY THAT THE ABOVE IS A CORRECT PLOT OF A SURVEY MADE BY ME.

FILE NO.	DATE	SCALE
	7/24/71	1"=60'

Charles H. Boyer  
REG. SURVEYOR NO. 5720