

THE JERRY A. MALOTT SURVEYING Co.

6810 EAST MAIN STREET ~ REYNOLDSBURG, OHIO 43068 ~ (614) 577-0957

80666775
80856775

O 34 C



PLAT OF 3.004 ACRES

IN



V.M.S. 6840, FRANKLIN COUNTY, OHIO

FOR

SOUTHWEST BROKERS

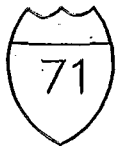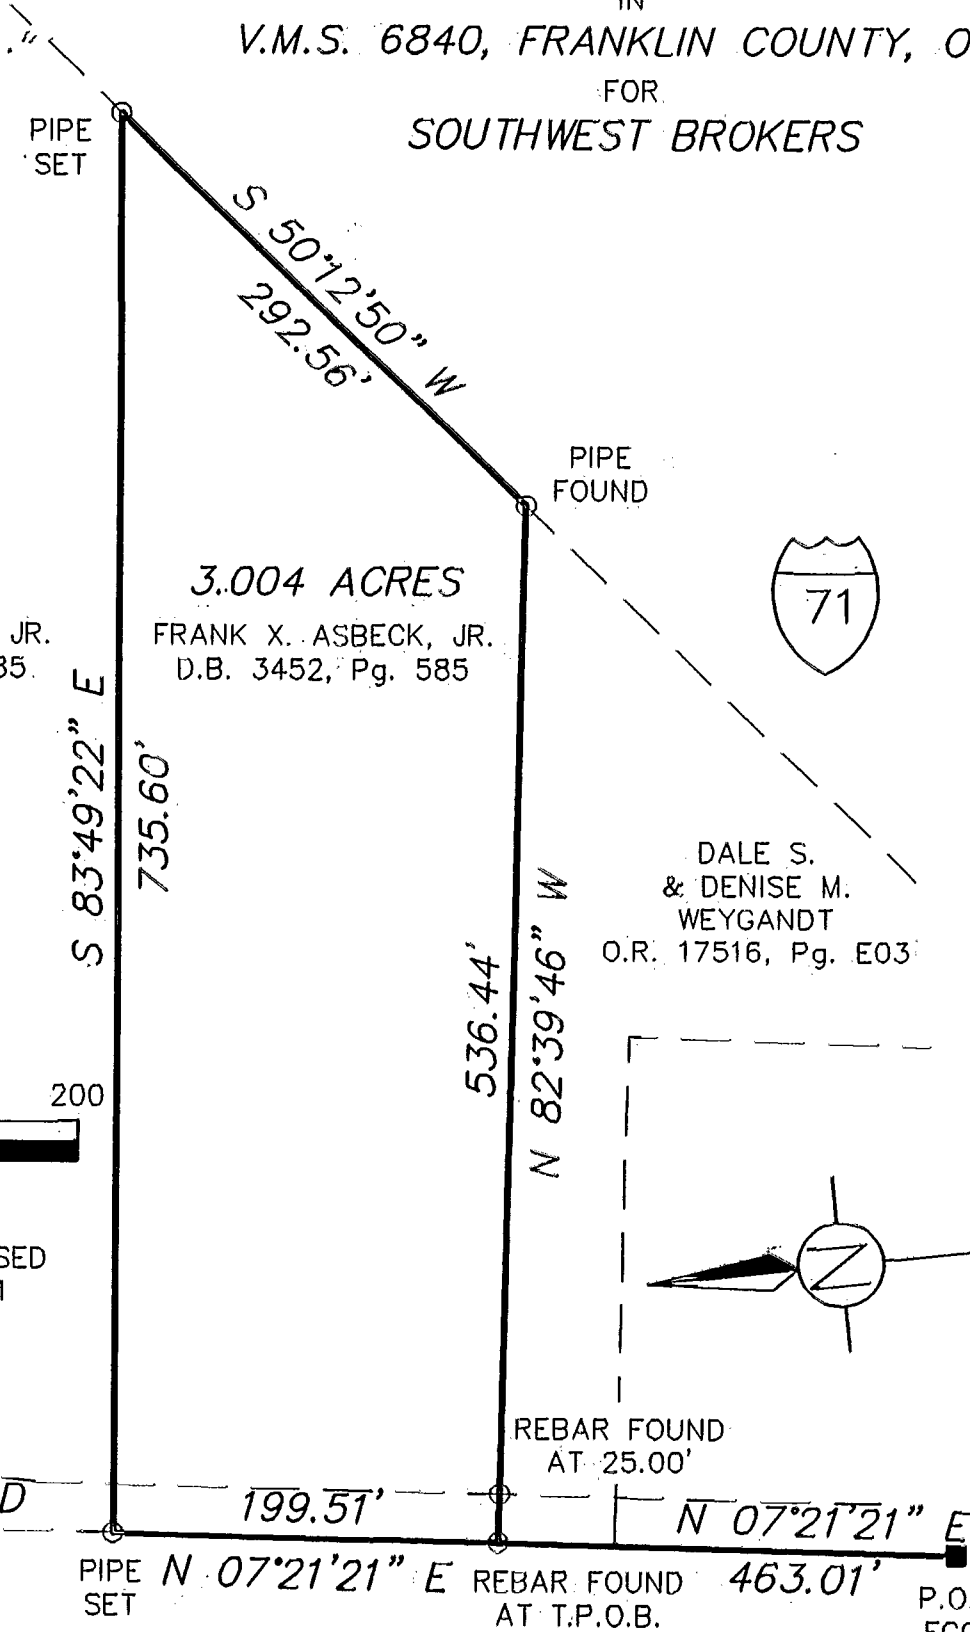

DALE S.
& DENISE M.
WEYGANDT
O.R. 17516, Pg. E03

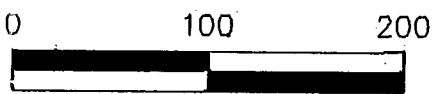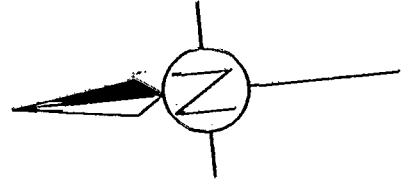

SCALE 1"=100'
6-19-92
BEARINGS ARE BASED
ON C.L. OF I-71


Jerry A. Malott
JERRY A. MALOTT
PROFESSIONAL SURVEYOR NO. 5963



9-34-C
JACKSON TRAP