


JERRY A. MALOTT SURVEYING Co.

6810 East Main Street ~ Suite 101, Columbus, Ohio 43068 (614) 577-0957

FOR: Southwest Brokers

BOUNDARY SURVEY 5.017 Acres

80606725
80856750
5462588

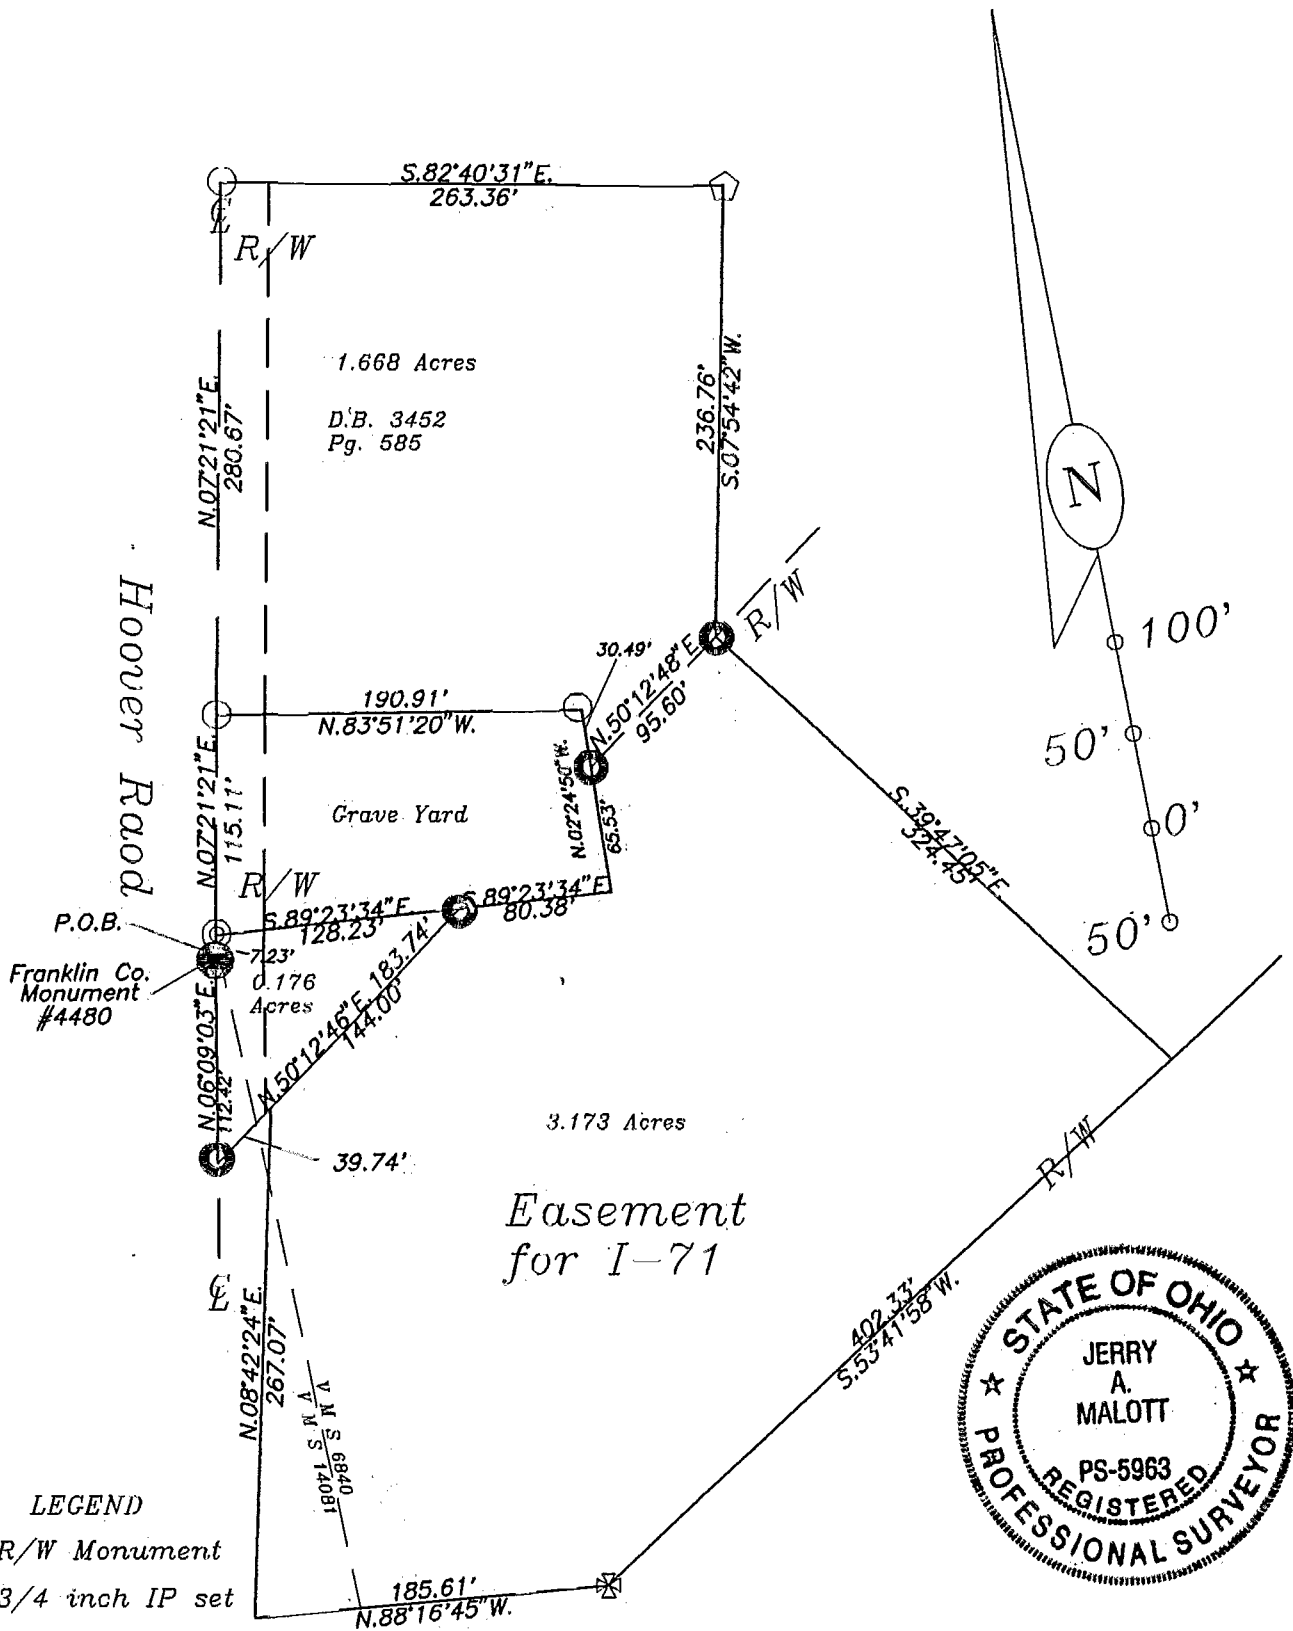

LEGEND

- ⊠ R/W Monument
- ⊙ 3/4 inch IP set
- Railroad spike set
- ⊙ Railroad spike found
- ⬠ 3/4 inch IP found



BY Jerry A. Malott
Professional Surveyor
JERRY A. MALOTT

SCALE 1" = 100' DATE 7-15-92

LOCATION: State of Ohio, County of Franklin, and being a total of 5.017 Acres, D.B. 3452, Pg. 585.

C-342
JACKSON TWP

Basis of bearing based on the centerline I 71 as being North 50°12'12" East.