EMHT INC.
CONSULTING ENGINEERS & SURVEYORS
GAHANNA, OHIO 43230

SURVEY OF ACREAGE PARCEL
VIRGINIA MILITARY SURVEY NO. 8231
CITY OF GROVE CITY,
JACKSON TOWNSHIP, FRANKLIN COUNTY, OHIO
EXHIBIT C18

SCALE 1" = 100'

FEBRUARY 8, 2002

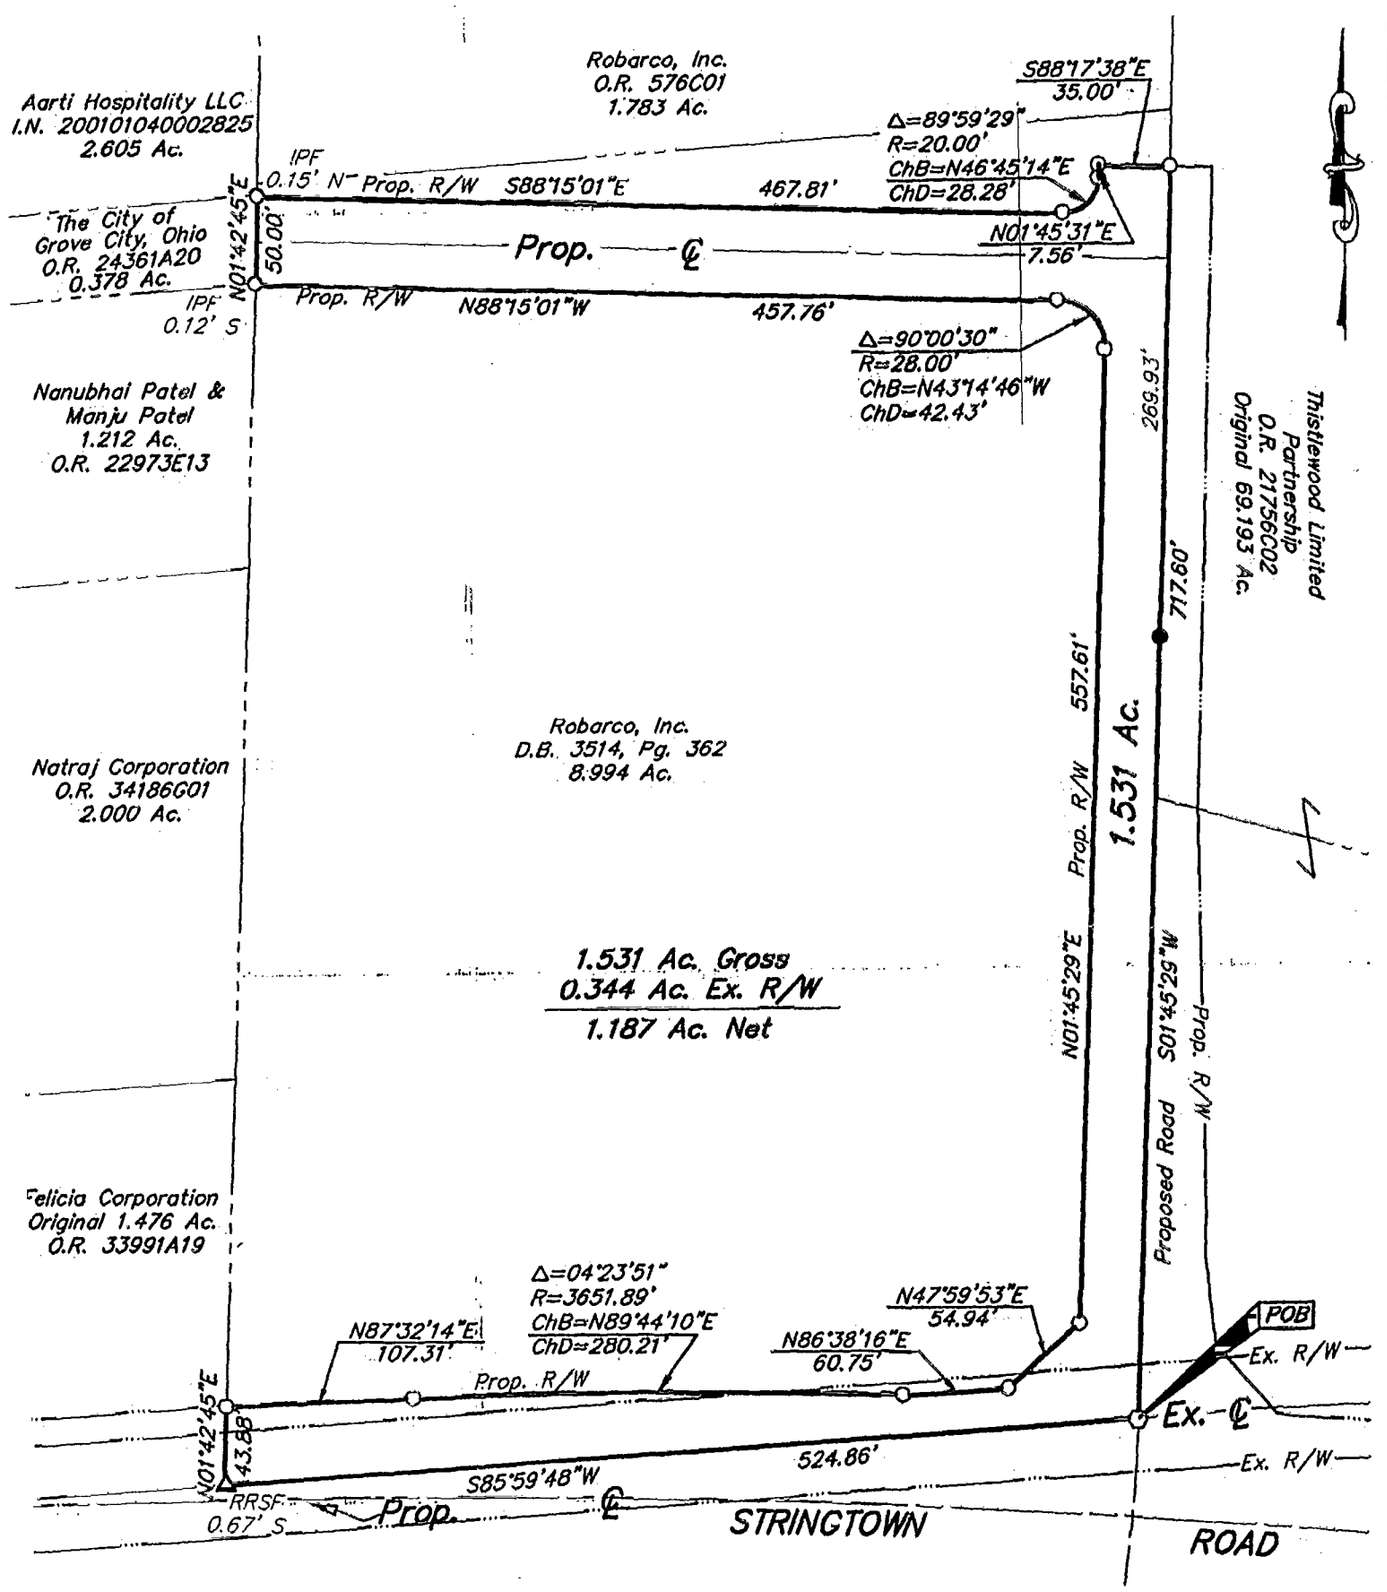

● = I.P. FND.
○ = I.P. SET
⬢ = MAG. NAIL FND.
⬡ = MAG. NAIL SET
▲ = R.R. SPK. FND.
△ = R.R. SPK. SET
⬟ = P.K. NAIL FND.

I.P.S Set are 13/16" I.D. Iron pipe W/ cap inscribed EMHT INC.

0' 0 100' 200'

GRAPHIC SCALE (IN FEET)

STATE OF OHIO
JOHN C. DODGION 8069
REGISTERED PROFESSIONAL SURVEYOR

ne bearings for this plat are based on the Ohio State ane Coordinate System as per NAD83. Control for bearings ns from coordinates of monuments FRANK 25 & FRANK 125, ving a bearing of South 87°46'00" East, established by the anklin County Engineering Department, using Global Positioning stem procedures and equipment.

By John C. Dodgion
John C. Dodgion No. 8069

8160825

0-32-G
JACKSON TWP.