


**SURVEY OF ACREAGE PARCEL**  
 VIRGINIA MILITARY SURVEY NO. 469  
 CITY OF GROVE CITY, FRANKLIN COUNTY, OHIO  
 EXHIBIT C7

81606825

SCALE 1" = 200'


FEBRUARY 6, 2002.

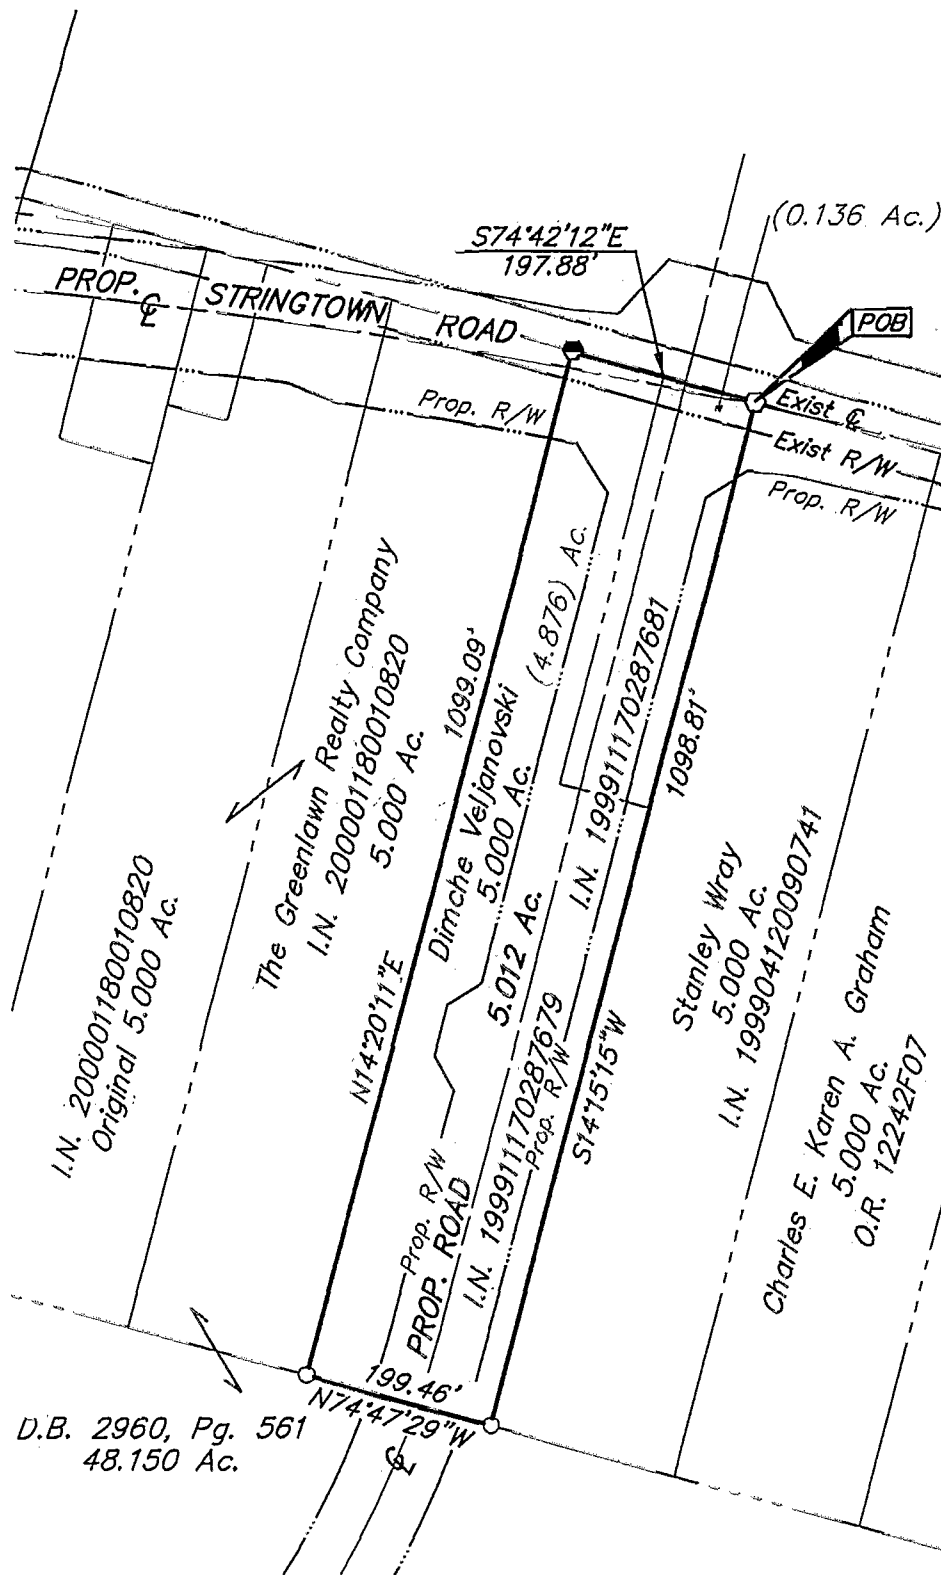

The bearings for this plat are based on the Ohio State Plane Coordinate System as per NAD83. Control for bearings was from coordinates of monuments FRANK 25 & FRANK 125, having a bearing of South 87°46'00" East, established by the Franklin County Engineering Department, using Global Positioning System procedures and equipment.

- = MON. FND.
- = I.P. FND.
- = I.P. SET
- ◆ = MAG. NAIL FND.
- ◇ = MAG. NAIL SET
- ▲ = R.R. SPK. FND.
- △ = R.R. SPK. SET
- ◆ = P.K. NAIL FND.

I.P.S. Set are 13/16" I.D. Iron pipe W/ cap inscribed EMHT INC

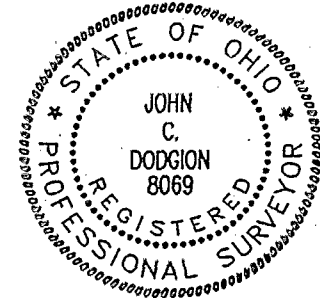

GRAPHIC SCALE (IN FEET)

**E.M.H.&T. INC.**

By John C. Dodgion  
 Professional Surveyor No. 8069

Jackson Twp.

0-32-G