EMH&T INC.
CONSULTING ENGINEERS & SURVEYORS
GAHANNA, OHIO 43230

SURVEY OF ACREAGE PARCEL
VIRGINIA MILITARY SURVEY NO. 469
JACKSON TOWNSHIP, FRANKLIN COUNTY, OHIO
EXHIBIT C2

SCALE 1" = 60'

JANUARY 31, 2002

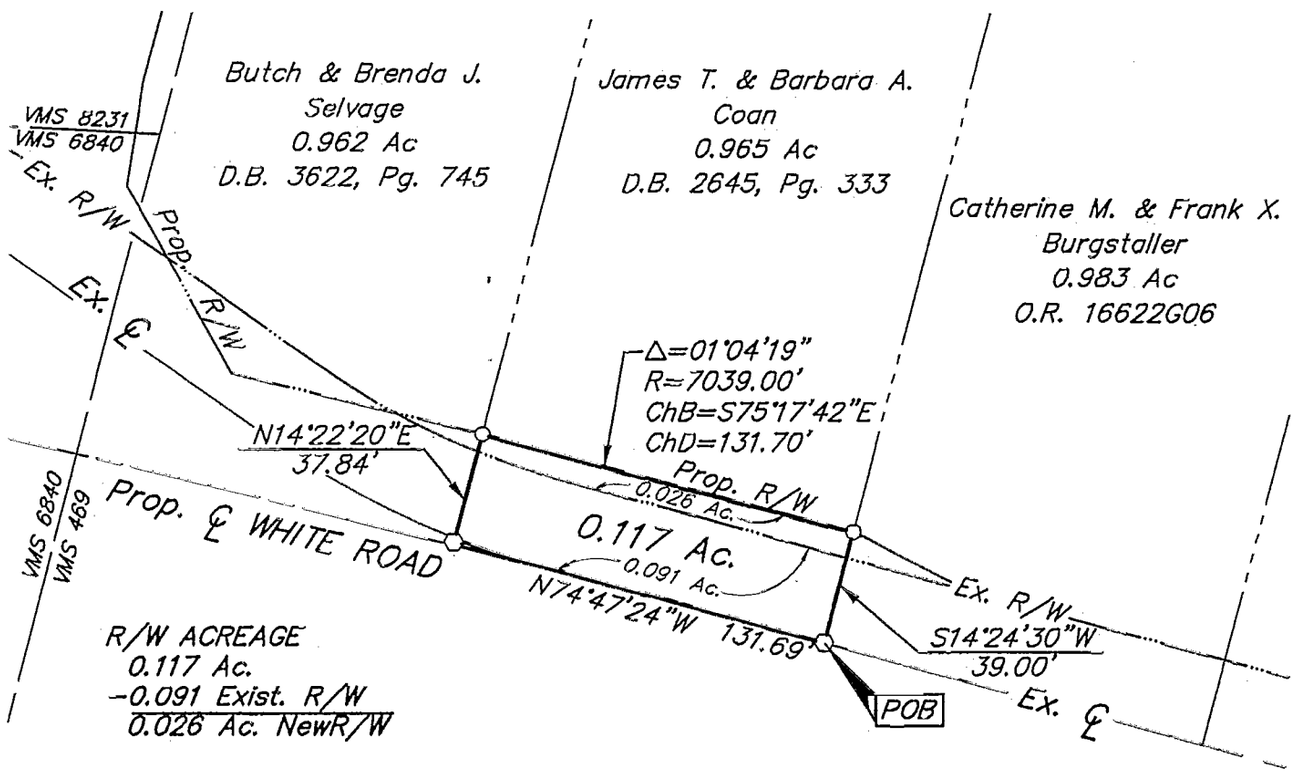

R/W ACREAGE
0.117 Ac.
-0.091 Exist. R/W
0.026 Ac. NewR/W

● = I.P. FND.
○ = I.P. SET
⬢ = MAG. NAIL FND.
⬡ = MAG. NAIL SET
▲ = R.R. SPK. FND.
△ = R.R. SPK. SET
⬟ = P.K. NAIL FND.

I.P.S Set are 13/16" I.D. Iron pipe W/ cap inscribed EMHT INC.

60' 0 60' 120'

GRAPHIC SCALE
(IN FEET)

STATE OF OHIO
JOHN C. DODGION 8069
REGISTERED PROFESSIONAL SURVEYOR

The bearings for this plat are based on the Ohio State Plane Coordinate System as per NAD83. Control for bearings was from coordinates of monuments FRANK 25 & FRANK 125, having a bearing of South 87°46'00" East, established by the Franklin County Engineering Department, using Global Positioning System procedures and equipment.

By John C. Dodgion
John C. Dodgion No. 8069

STRINGTOWN BUCKEYE PKWY ESTIMATES 20020313.01

B/C 06 800

Jackson Twp.

C-32-G