BAUER, BOROWITZ & MERCHANT, INC.

CONSULTING ENGINEERS

O-111-E

2607½ NORTH HIGH STREET COLUMBUS, OHIO 43202

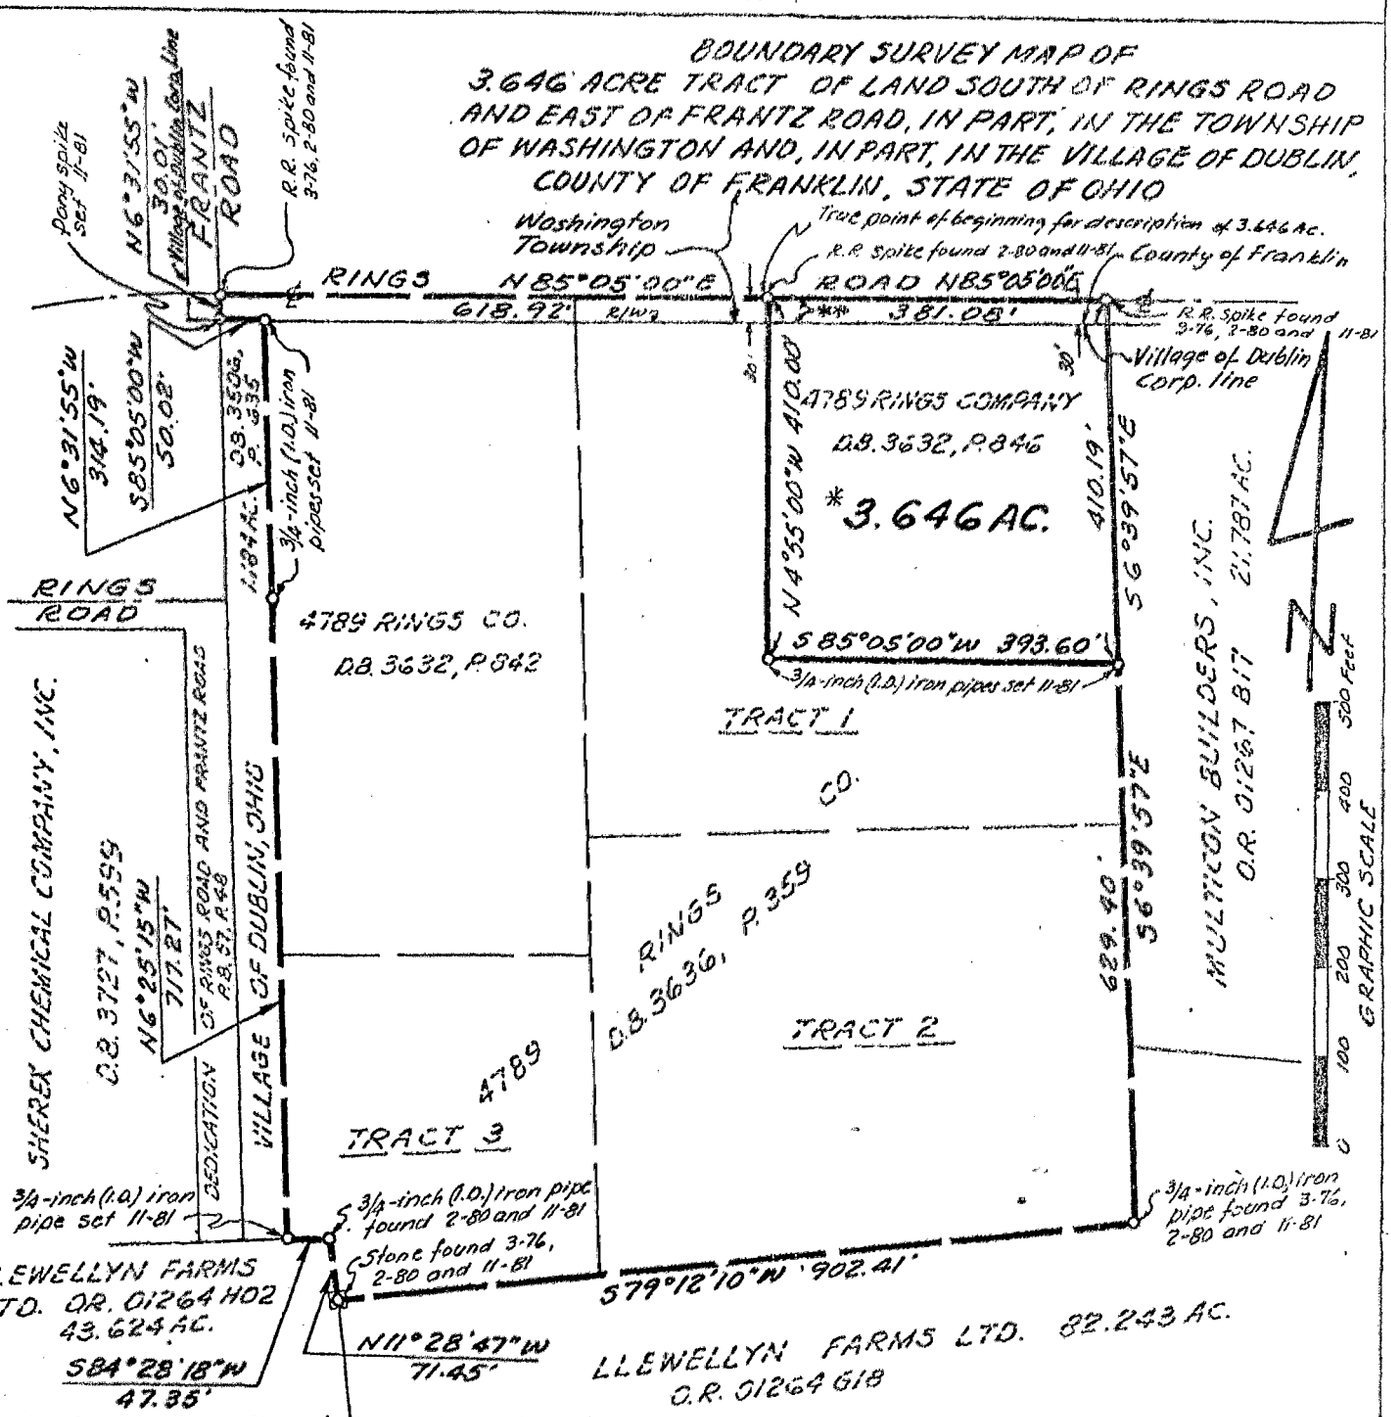

* Situated in the State of Ohio, County of Franklin, in part, in the Township of Washington and, in part, in the Village of Dublin, being in Virginia Military Survey No. 2419 and being 3.646 acres of land, more or less, said 3.646 acres of land being all of that tract of land conveyed to 4789 Rings Company, by deed of record in Deed Book 3632, Page 846, Recorder's Office, Franklin County, Ohio.

TO: BANK ONE OF COLUMBUS NA and BUILDER-DEVELOPER TITLE AGENCY, INC.

We hereby certify that this map was prepared from information obtained from actual field surveys conducted by Bauer, Borowitz & Merchant, Inc. in March of 1976, February of 1980 and November of 1981, and that, to the best of our knowledge and belief, said map is correct.

The survey markers noted hereon were in place in November of 1981.

The bearings shown on this map are based on an assumed meridian

** Only that portion of said 3.646 acre tract of land that is located within said Rings Road right-of-way is situated in the Township of Washington.

Scale: 1" = 200'

December 27, 1983

Order No. 2852-83

Revised December 28, 1983

BAUER, BOROWITZ & MERCHANT, INC.
Consulting Engineers

By Gatis Erenpreiss

Gatis Erenpreiss
Registered Surveyor No. 5572