D-34-B

Recd. 8-15-58

D-34-B

Property in Jackson Twp, Franklin Co., Ohio
Scale 1" = 200' I.P. = Iron Pin
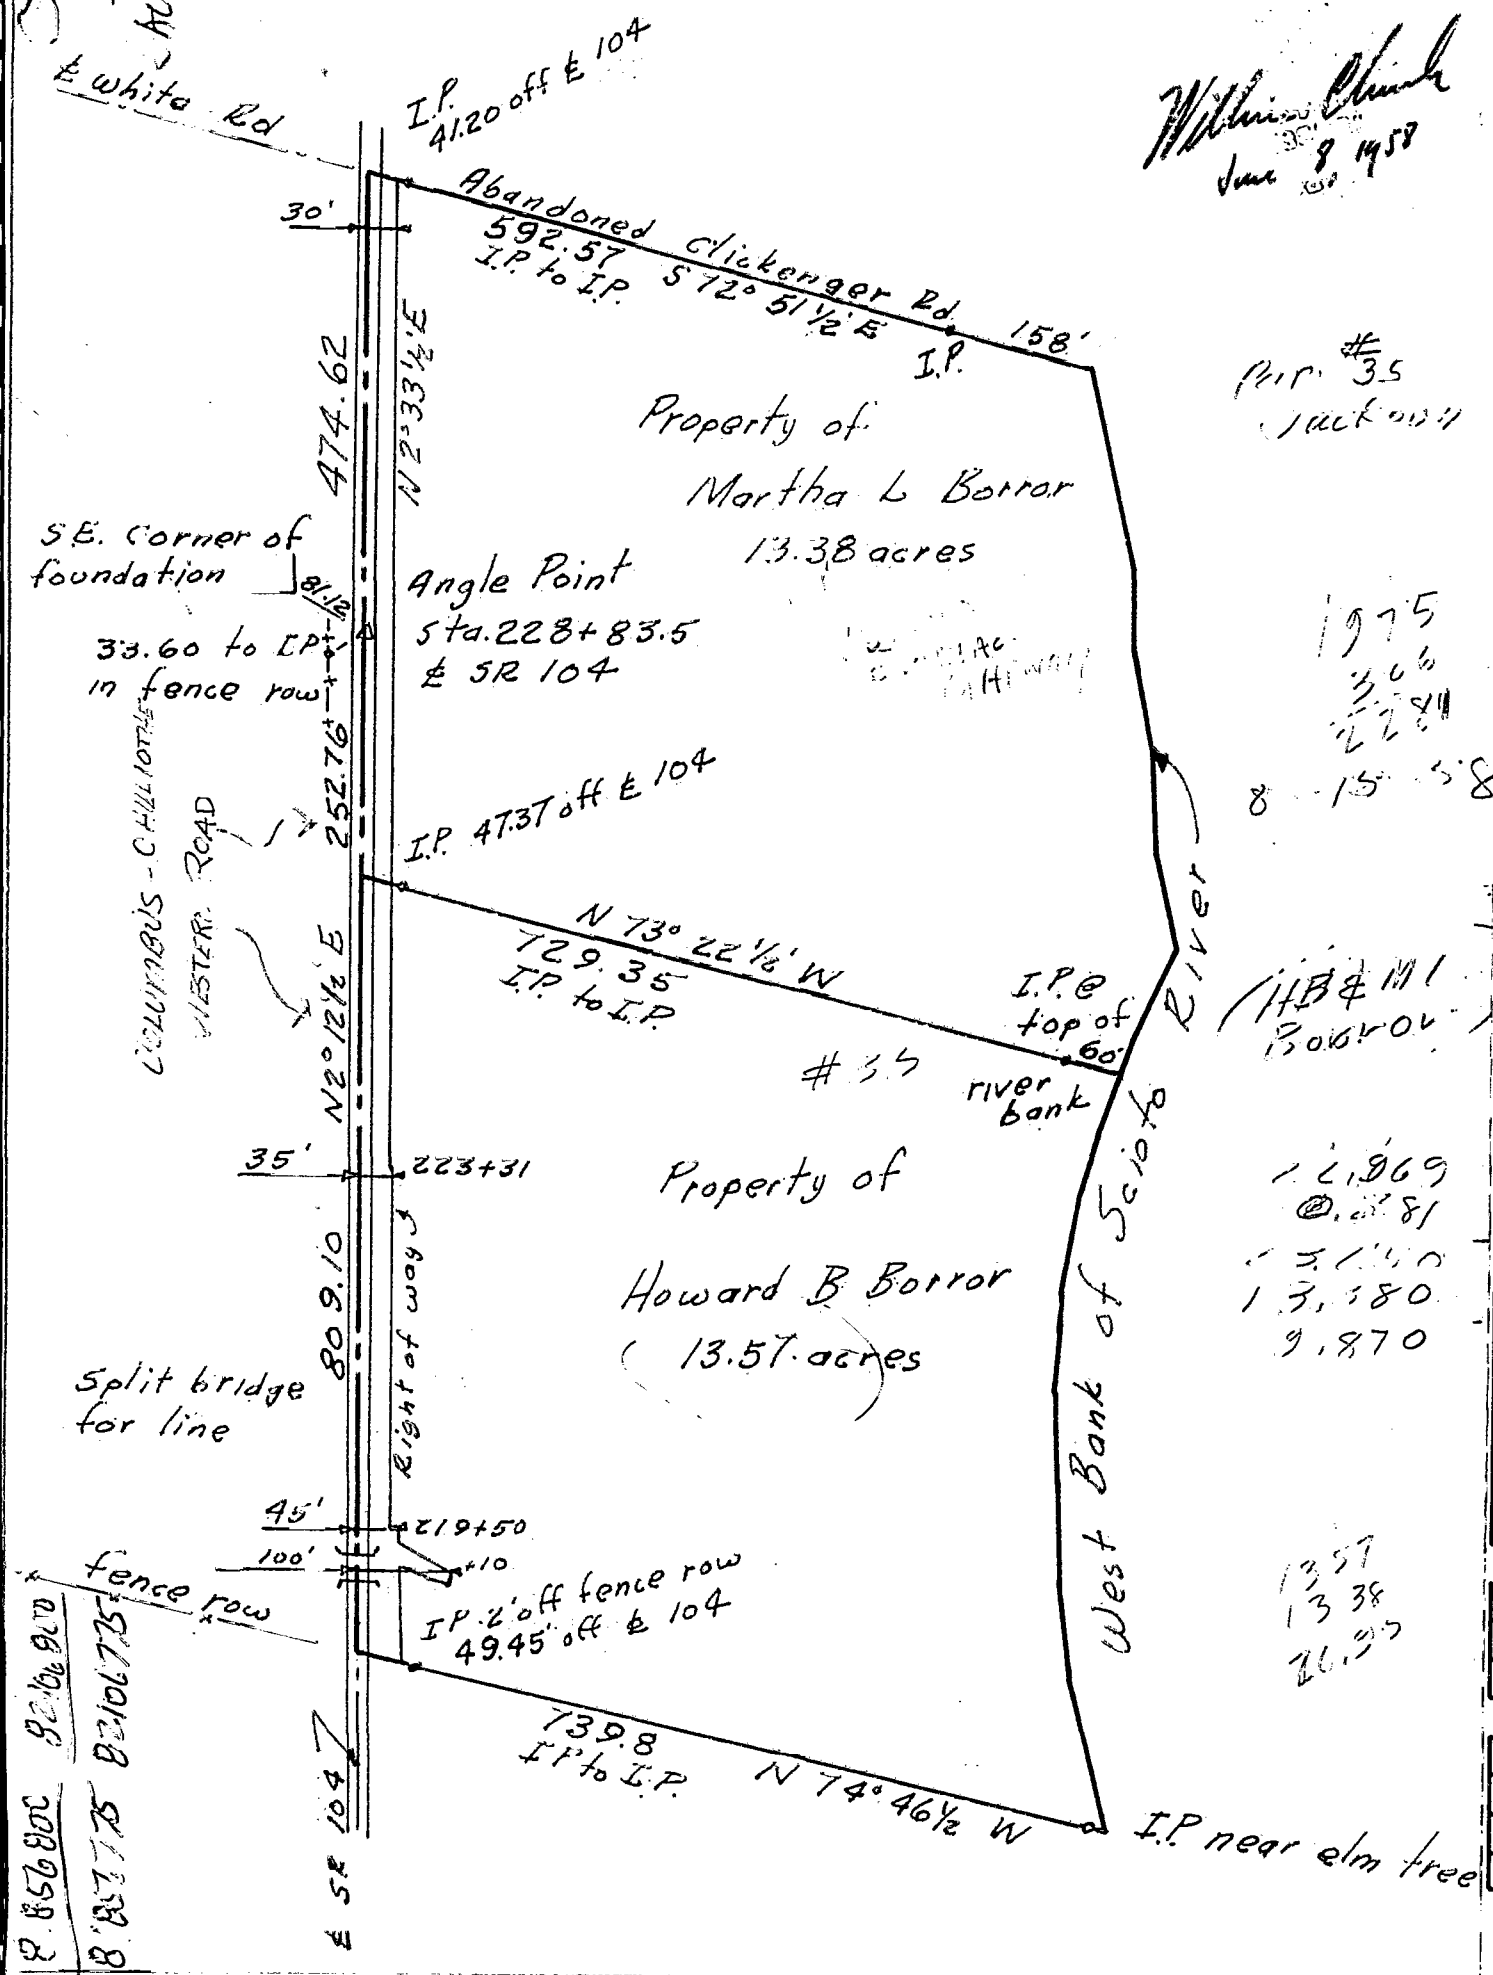
Wilbur Clark
June 9 1958