

THE THOMAS ENGINEERING & SURVEYING COMPANY

3803 SULLIVANT AVENUE

COLUMBUS, OHIO 43228

ORDER NO. 105-69

0-32-T


PLAT of SURVEY

of an 8.000 acre tract, out of a 20.000 acre tract, located in the State of Ohio, County of Franklin, Township of Jackson, VMS No. 469, For

Marvene RIGGS.

SCALE 1" = 100'

Feb., 1969.

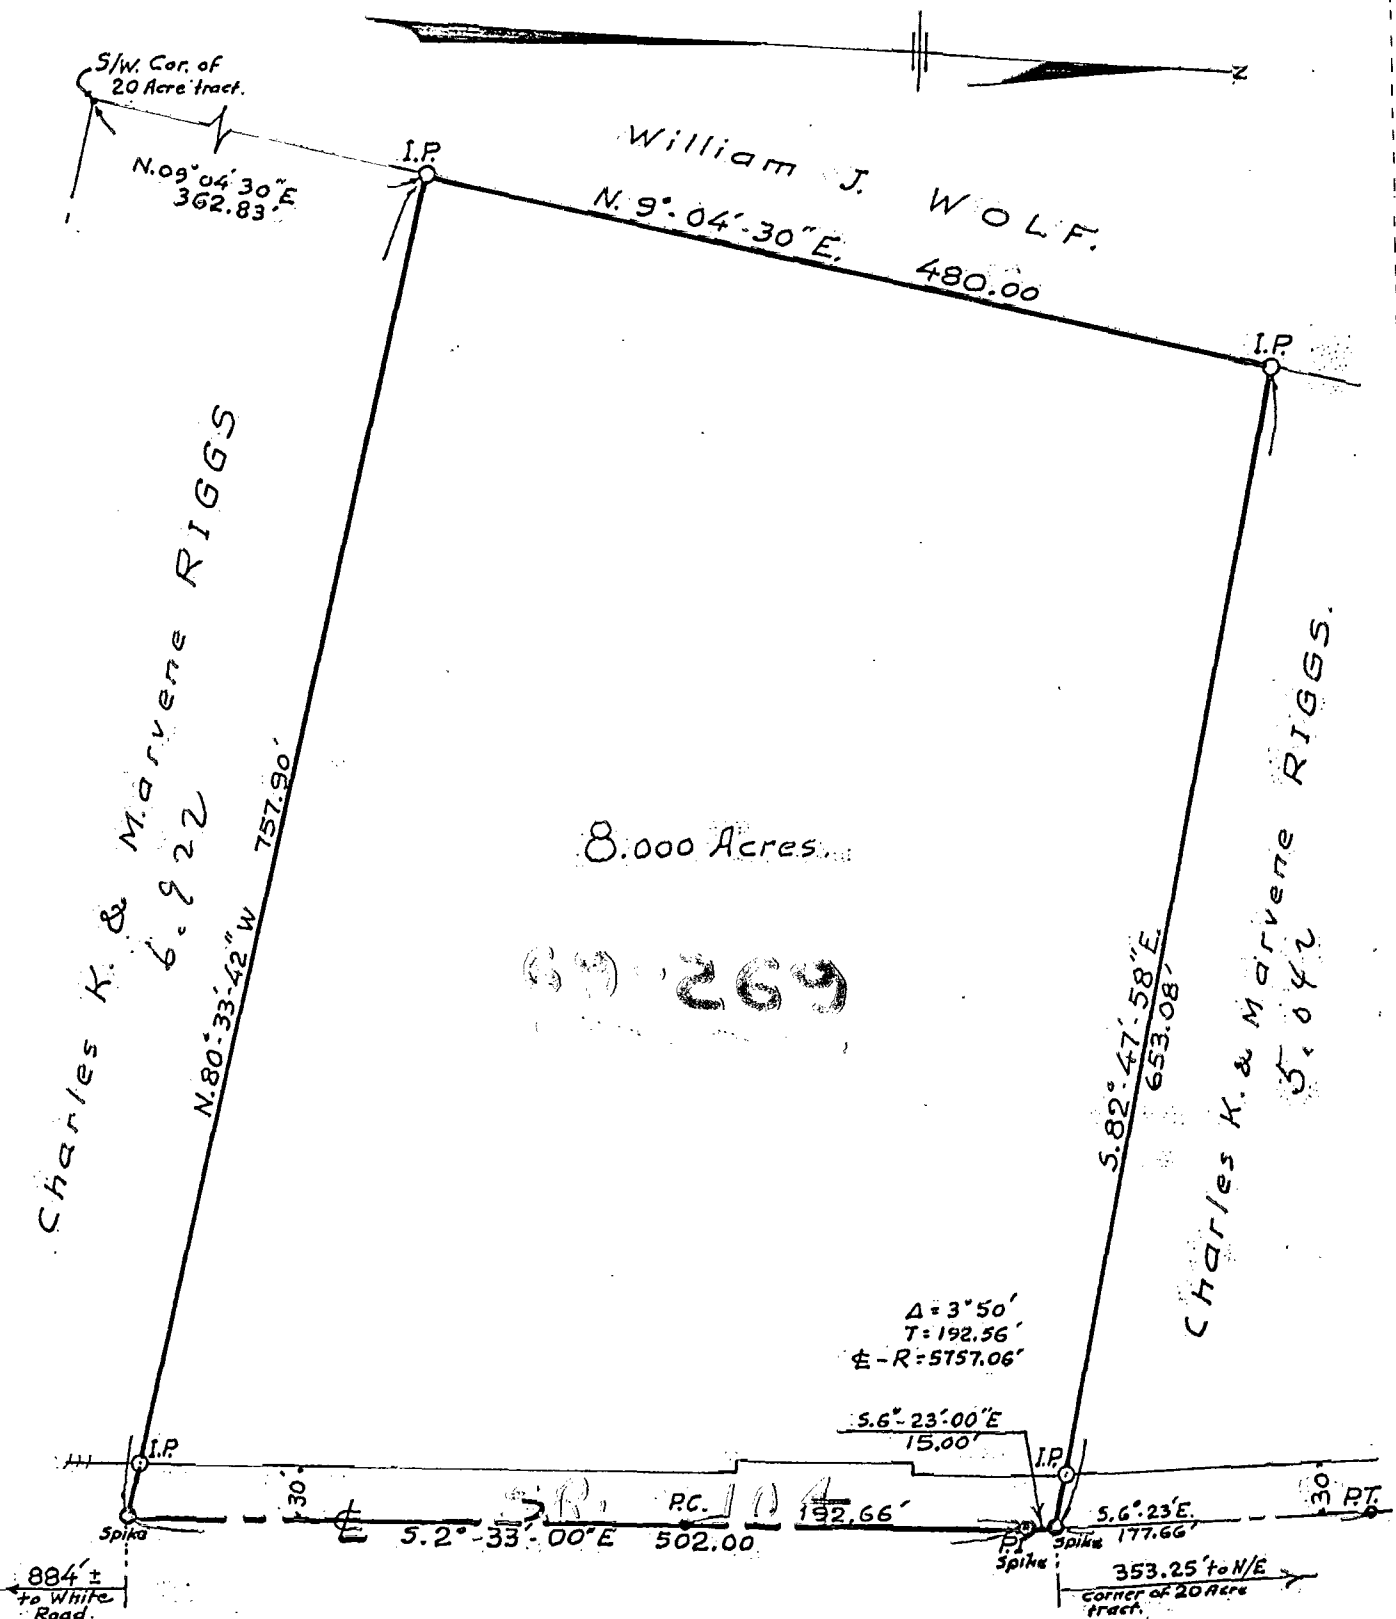

We hereby certify that the foregoing drawing was prepared from an actual survey of the premises and correctly shows the location of the boundaries.

F.C.R.P.E
Comply with the regulations
M.M. 3-26-69

THE THOMAS ENGINEERING & SURVEYING CO.

Richard W. Conrad
Registered Surveyor

C-1414

FILED
C-32-H
8 852 8

0323
1969
04
06
