



HAMILTON TWP
C-34

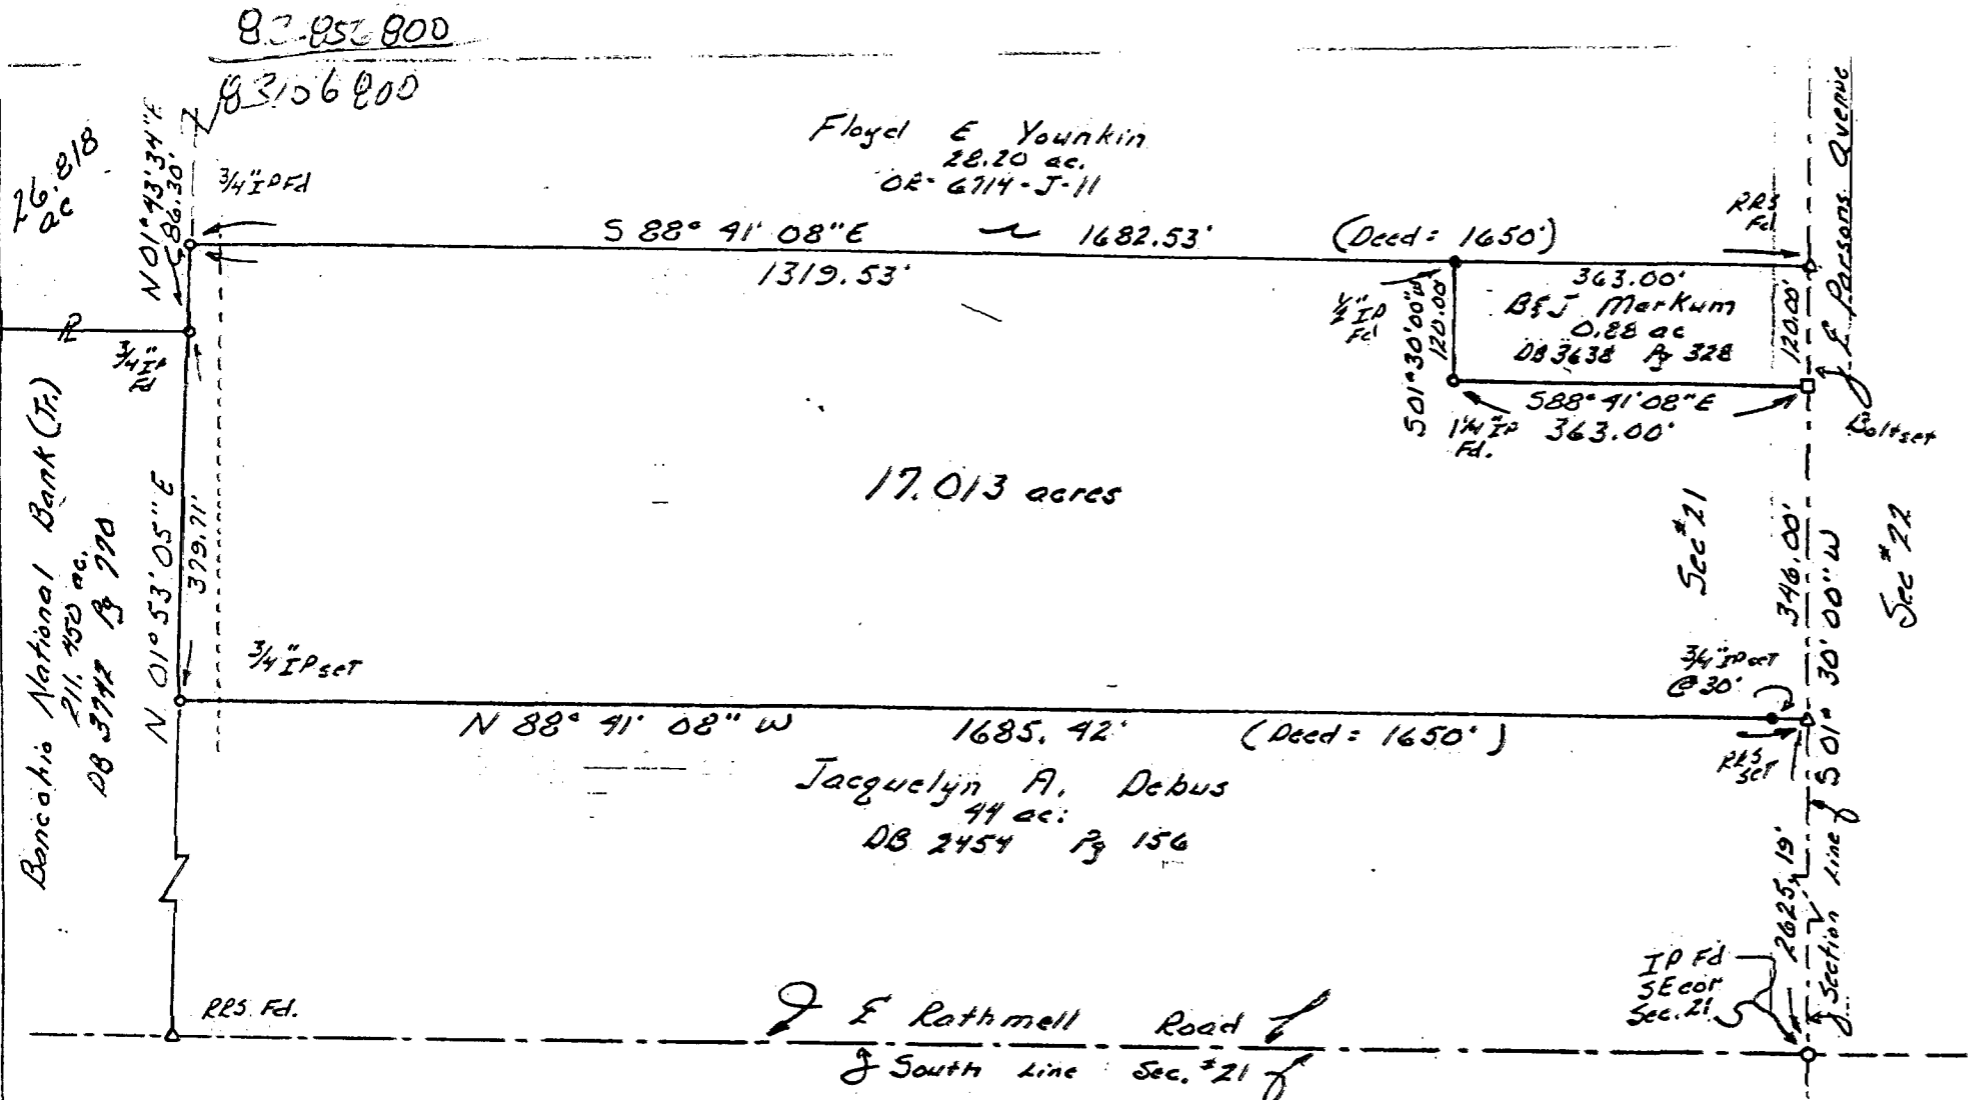

Survey of 17.013 acres
 in the East 1/2 of Sec #2,
 Twp 4, Rge 22, Hamilton Twp.,
 Franklin Co., Ohio for
Jaquelyn A. Debus

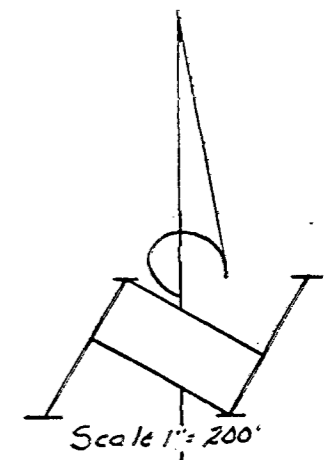

Louis F Haines
 354 Kessler Street
 Groveport, Ohio 43125
 Phone 637-2181

(HEREBY CERTIFY THE PLAT SHOWN HEREON
 IS CORRECT AS SURVEYED BY US.
 DATE: April 24, 1986
 SIGNED: Louis F. Haines

