

EVANS MECHWART HAMBLETON & TILTON

CIVIL ENGINEERS — SURVEYORS  
GAHANNA, OHIO

Par 133

Thomas Charles #

SURVEY OF 8.540 Ac. TRACT

Located in Virginia Military Survey #478  
Jackson Township, Franklin County, Ohio

O-34-D

SCALE 1" = 200'

February 16, 1963  
o = Iron Pin

DEED BOOK — PAGE  
PLAT BOOK — PAGE

03

0544

1963

04

05

06

07

08


09

10

11

12

COLUMBUS-CHILlicothe WESTERN ROAD

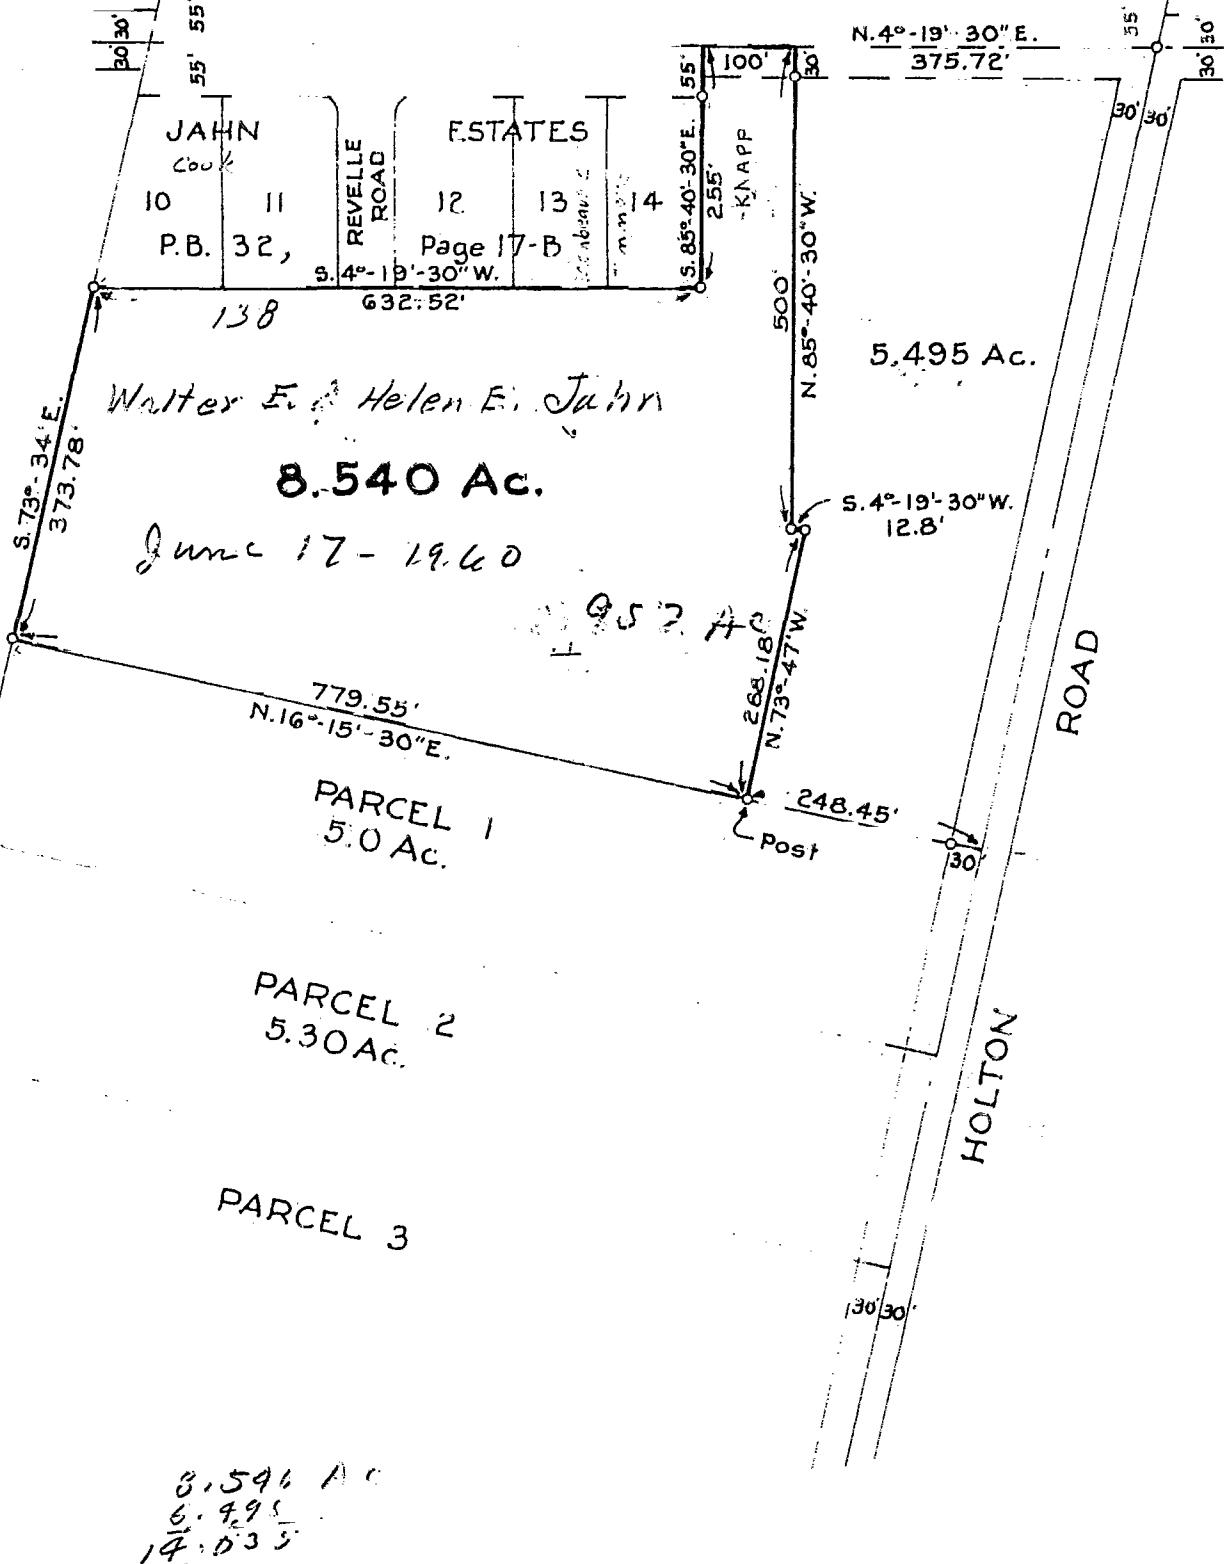

8.540 Ac.  
6.495  
14.035

We hereby certify that the foregoing plat was prepared from an actual survey of the premises and shows the location of the boundaries

EVANS MECHWART HAMBLETON & TILTON

Registered Surveyor # 483

238-63-Jahn

Jackson Twp  
O-34-D

2296  
2297  
2298  
2299